

CARD MUST BE TYPED

State of Kansas

CARD MUST BE SIGNED

NOTICE OF INTENTION TO DRILL

(see rules on reverse side)

*CORRECTED CARD

Expected Spud Date..... 09/29/88
month day year

API Number 15— 125-29,095-00-00

OPERATOR: License # 4469
 Name KELT ENERGY
 Address 900 COLLEGE DRIVE
 City/State/Zip INDEPENDENCE 67301
 Contact Person FADI NAMMOUR
 Phone (316) 331-0207

APP SW NW SE Sec. 12 Twp. 34 S, Rg. 13
 * 1440 East
 * 2310 West
 Ft. from South Line of Section
 Ft. from East Line of Section

(Note: Locate well on Section Plat on reverse side)

CONTRACTOR: License # 9350
 Name THOMPSON DRILLING CO., INC.
 City/State 125 S. 26TH ST., PO BOX 67301

Nearest lease or unit boundary line 330 feet
 County MONTGOMERY
 Lease Name DALBY Well # KHHD-1
 Ground surface elevation 780 feet MSL

Well Drilled For: Well Class: Type Equipment:
 XX Oil — Storage — Infield XX Mud Rotary
 XX Gas — Inj — Pool Ext. — Air Rotary
 — OWWO — Expl XX Wildcat — Cable

Domestic well within 330 feet: —yes XX no
 Municipal well within one mile: —yes XX no

Depth to bottom of fresh water... 165

Depth to bottom of usable water... 175

Surface pipe by Alternate: 1 2 XX

Surface pipe planned to be set 20

Conductor pipe required *****

Projected Total Depth 1550 feet

Formation MISSISSIPPI

If OWWO: old well info as follows:

Operator

Well Name

Comp Date Old Total Depth

I certify that well will comply with K.S.A. 55-101, et seq., plus eventually plugging hole to KCC specifications.

Date 10/03/88 Signature of Operator or Agent Title AS AGENT

For KCC Use:

Conductor Pipe Required feet; Minimum Surface Pipe Required 20' feet per Alt. X (2)

This Authorization Expires 3-27-89 Approved By LKM 10-4-88 Orig. Rev'd: 9-27-88


EFFECTIVE DATE: 10-9-88

* WAS: 1640' FSL, 2410' FEL

Must be filed with the K.C.C. five (5) days prior to commencing well
This card void if drilling not started within six (6) months of date received by K.C.C.

Important procedures to follow:

1. Notify District office before setting surface casing.
 2. Set surface casing by circulating cement to the top.
 3. File completion forms ACO-1 with K.C.C. within 120 days of well spud date, following instructions on ACO-1, side 1, and including copies of wireline logs.
 4. Notify District office 48 hours prior to old well workover or re-entry.
 5. Prior to filing Intent, prepare a proposed plugging plan in case well is D & A, then obtain approval of plan when calling district office prior to setting surface pipe.
 6. Submit plugging report (CP-4) to K.C.C. after plugging is completed.
 7. Obtain an approved injection docket number before disposing of salt water.
- Notify K.C.C. within 10 days when injection commences or terminates.

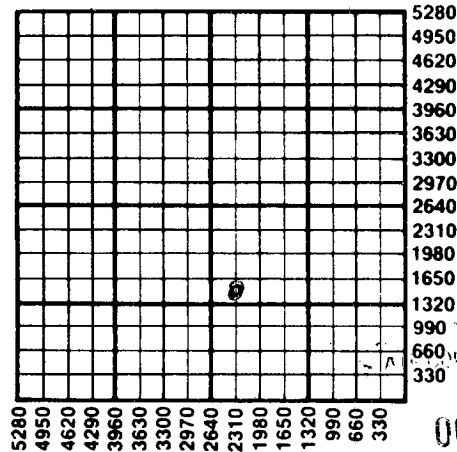

RECEIVED

STATE CORPORATION COMMISSION

WICHITA, KANSAS

OCT 3 1988

CONSERVATION DIVISION
Wichita, Kansas

103-88

State Corporation Commission of Kansas
Conservation Division
200 Colorado Derby Building
Wichita, Kansas 67202-1212
(316) 263-3238