

CARD MUST BE TYPED

State of Kansas

CARD MUST BE SIGNED

NOTICE OF INTENTION TO DRILL

(see rules on reverse side)

Expected Spud Date..... 10/05/88
 month day year
 4469

OPERATOR: License #..... KELL ENERGY

Name..... 900 COLLEGE DRIVE

Address..... INDEPENDENCE 67301

City/State/Zip..... FADI NAMMOUR

Contact Person..... (316) 331-0207

Phone..... 9350

CONTRACTOR: License #..... THOMPSON DRILLING CO., INC.

Name..... 125 S. 26TH ST., PO BOX 67301

City/State.....

Well Drilled For: Well Class: Type Equipment:

XX Oil XX Infield XX Mud Rotary

XX Gas XX Pool Ext. XX Air Rotary

XX OWWO XX Wildcat XX Cable

If OWWO: old well info as follows:

Operator.....

Well Name.....

Comp Date..... Old Total Depth.....

I certify that well will comply with K.S.A. 55-101, et seq., plus eventually plugging hole to KCC specifications.

Date..... 10/05/88 Signature of Operator or Agent.....

For KCC Use:

Conductor Pipe Required..... feet; Minimum Surface Pipe Required..... 20' feet per Alt. X (2)

This Authorization Expires..... 4-5-89 Approved By LKM 10-5-88

EFFECTIVE DATE: 10-10-88

API Number 15-125-29,099-00-00

SW SW SE 12 34 13 East

330 Sec 330 Twp S, Rg West

2310 Ft. from South Line of Section

2310 Ft. from East Line of Section

(Note: Locate well on Section Plat on reverse side)

Nearest lease or unit boundary line 330 feet

County..... MONTGOMERY

Lease Name..... DALBY Well #..... KHHD-3

Ground surface elevation..... 780 feet MSL

Domestic well within 330 feet: yes no

Municipal well within one mile: yes no

Depth to bottom of fresh water..... 165

Depth to bottom of usable water..... 175

Surface pipe by Alternate: 20' 2' XX

Surface pipe planned to be set.....

Conductor pipe required.....

Projected Total Depth..... 1550 feet


Formation..... MISSISSIPPI

AS AGENT

Must be filed with the K.C.C. five (5) days prior to commencing well
This card void if drilling not started within six (6) months of date received by K.C.C.

Important procedures to follow:

1. Notify District office before setting surface casing.
2. Set surface casing by circulating cement to the top.
3. File completion forms ACO-1 with K.C.C. within 120 days of well spud date, following instructions on ACO-1, side 1, and including copies of wireline logs.
4. Notify District office 48 hours prior to old well workover or re-entry.
5. Prior to filing Intent, prepare a proposed plugging plan in case well is D & A, then obtain approval of plan when calling district office prior to setting surface pipe.
6. Submit plugging report (CP-4) to K.C.C. after plugging is completed.
7. Obtain an approved injection docket number before disposing of salt water.
8. Notify K.C.C. within 10 days when injection commences or terminates.

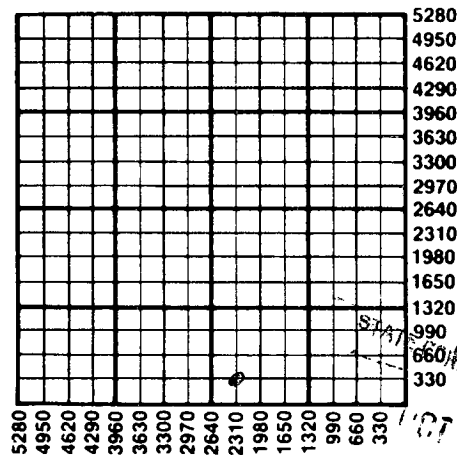

5 1988
CONSERVATION DIVISION
Wichita, Kansas

10-5-88

an alternate 2 completion, cement in the production pipe from below any usable water to surface within 120 days of spud date.

State Corporation Commission of Kansas
Conservation Division
200 Colorado Derby Building
Wichita, Kansas 67202-1212
(316) 263-3238