

CARD MUST BE TYPED

State of Kansas
NOTICE OF INTENTION TO DRILL

CARD MUST BE SIGNED

(see rules on reverse side)

Starting Date: Feb. 20, 1985
month day year

API Number 15- 065-22,143-00-00

OPERATOR: License # 5058

SW NE SE (location) Sec 17 Twp 9 S, Rge 21 East West

Name Griggs Oil, Inc.
Address 714 S. Hillside
City/State/Zip Wichita, Kansas 67211
Contact Person Jim Collins
Phone (316) 682-6716

1650 Ft North from Southeast Corner of Section
990 Ft West from Southeast Corner of Section
(Note: Locate well on Section Plat on reverse side)

CONTRACTOR: License # 9087
Name R & C Drilling, Inc.
City/State Box 2968, Hays, Kansas 67601

Nearest lease or unit boundary line 990 feet.
County Graham
Lease Name Cooley Well# 5
Domestic well within 330 feet: yes no
Municipal well within one mile: yes no

Well Drilled For: Well Class: Type Equipment:
 Oil Swd Infield Mud Rotary
 Gas Inj Pool Ext. Air Rotary
 OWWO Expl Wildcat Cable

Depth to Bottom of fresh water 120 ^{with} 90 feet
Lowest usable water formation Dakota 70
Depth to Bottom of usable water 900 90 feet
Surface pipe by Alternate: 1 2
Surface pipe to be set 260 feet
Conductor pipe if any required -0- feet
Ground surface elevation 2235 feet MSL
This Authorization Expires 8-8-85
Approved By 2-8-85 *R*

If OWWO: old well info as follows:
Operator
Well Name
Comp Date Old Total Depth
Projected Total Depth 3750 feet
Projected Formation at TD Arbuckle
Expected Producing Formations Arbuckle

I certify that we will comply with K.S.A. 55-101, et seq., plus eventually plugging hole to K.C.C. specifications.

Date 2-6-85
Signature of Operator or Agent *James H Collins*


Title Vice President

MHC/ADHE 2-8-85 Form C-1 4/84

Must be filed with the K.C.C. five (5) days prior to commencing well
 This card void if drilling not started within six (6) months of date received by K.C.C.

Important procedures to follow :

A Regular Section of Land
1 Mile = 5,280 Ft.

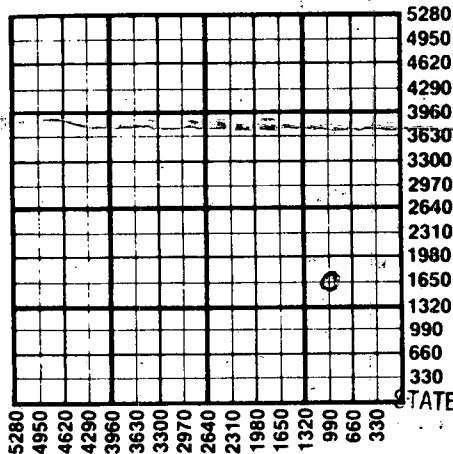

1. Notify District office before setting surface casing.
 2. Set surface casing by circulating cement to the top.
 3. File completion forms ACO-1 with K.C.C. within 90 days of well completion, following instructions on ACO-1, side 1, and including copies of wireline logs.
 4. Notify District office 48 hours prior to old well workover or re-entry.
 5. Prior to plugging, prepare a plugging plan, then obtain agreement from the appropriate district office for an approved plugging plan.
 6. Submit plugging report (CP-4) to K.C.C. after plugging is completed.
 7. Obtain an approved injection docket number before disposing of salt water.
 8. Notify K.C.C. within 10 days when injection commences or terminates.
9. If an alternate 2 completion, cement in the production pipe from below and use usable water to surface within 120 days of spud date.

RECEIVED

STATE CORPORATION COMMISSION
 2/8/85
 FEB 08 1985

CONSERVATION DIVISION
 Wichita, Kansas

State Corporation Commission of Kansas
 Conservation Division
 200 Colorado Derby Building
 Wichita, Kansas 67202
 (316) 263-3238