

CARD MUST BE TYPED

State of Kansas
NOTICE OF INTENTION TO DRILL

CARD MUST BE SIGNED

(see rules on reverse side)

Starting Date: 5 7 85
month day year

API Number 15- 065-21,652-00-01

OPERATOR: License # 9963
Name CRUDE RECOVERY CORPORATION
Address 1650 Georgetown, Suite 200
City/State/Zip Wichita, KS 67218
Contact Person Vern Brungardt
Phone 316-681-3601

E/2 NW NE Sec 20 Twp 9 S, Rge 21
(location) East West

4620 Ft North from Southeast Corner of Section
1650 Ft West from Southeast Corner of Section
(Note: Locate well on Section Plat on reverse side)

CONTRACTOR: License # Unknown
Name
City/State

Nearest lease or unit boundary line 660 feet
County Graham
Lease Name Kortan Well# 3

Well Drilled For: Well Class: Type Equipment:

- Oil Swd Infield Mud Rotary
- Gas Inj Pool Ext. Air Rotary
- OWWO Expl Wildcat Cable

Domestic well within 330 feet: yes no
Municipal well within one mile: yes no

If OWWO: old well info as follows:

Operator Energy Three, Inc
Well Name #1 Kortan
Comp Date 4/82 Old Total Depth 3820'

Depth to Bottom of fresh water 120 feet
Lowest usable water formation Dakota
Depth to Bottom of usable water 950 feet

Projected Total Depth
Projected Formation at TD Arbuckle
Expected Producing Formations same

Surface pipe by Alternate: 1 2
Surface pipe ~~set~~ set 287 feet
Conductor pipe if any required
Ground surface elevation 226.7 feet MSL
This Authorization Expires 11-6-85
Approved By 5-6-85

I certify that we will comply with K.S.A. 55-101, et seq., plus eventually plugging hole to K.C.C. specifications.

Date 5/1/85 Signature of Operator or Agent

Vern Brungardt
Vern Brungardt

Title Manager

Form C-1 4/84


MHC/WOHE 5-6-85

RECEIVED
STATE CORPORATION COMMISSION

5/3/85
MAY 3 1985

Must be filed with the K.C.C. five (5) days prior to commencing well
This card void if drilling not started within six (6) months of date received by K.C.C.

CONSERVATION DIVISION
A Regular Section of Land
1" Mile = 5,280 Ft.

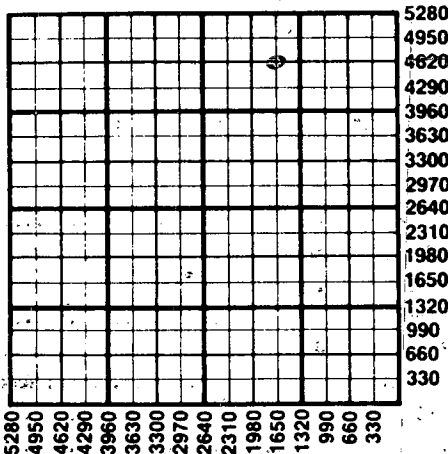

Important procedures to follow :

1. Notify District office before setting surface casing.
2. Set surface casing by circulating cement to the top.
3. File completion forms ACO-1 with K.C.C. within 90 days of well completion, following instructions on ACO-1, side 1, and including copies of wireline logs.
4. Notify District office 48 hours prior to old well workover or re-entry.
5. Prior to plugging, prepare a plugging plan, then obtain agreement from the appropriate district office for an approved plugging plan.
6. Submit plugging report (CP-4) to K.C.C. after plugging is completed.
7. Obtain an approved injection docket number before disposing of salt water.
8. Notify K.C.C. within 10 days when injection commences or terminates.
9. If an alternate 2 completion, cement in the production pipe from below any usable water to surface within 120 days of spud date.

State Corporation Commission of Kansas
Conservation Division
200 Colorado Derby Building
Wichita, Kansas 67202
(316) 263-3238