

CARD MUST BE SIGNED

API Number 15-

. E/2 SE. SE. . . Sec .10. Twp .9. . S, Rge .19. ☒ West
(location)

660 Ft North from Southeast Corner of Section

330 Ft West from Southeast Corner of Section

(Note: Locate well on Section Plat on reverse side)

Nearest lease or unit boundary line 330 feet.

County Rooks

Lease Name ...Tawney..... **Well#** ...1.....

Domestic well within 330 feet : ☐ yes ☒ no

Municipal well within one mile : ☐ yes ☒ no

☒ **Mud Rotary**☐ **Air Rotary**

☐ **Cable**

Depth to Bottom of fresh water 150 feet

Depth to Bottom of Fresh Water	feet
Lowest usable water formation	Dakota

Depth to Bottom of usable water 800 feet

Surface pipe by Alternate : 1 ☐ 2 ☒

Surface pipe to be set230..... **feet**

Conductor pipe if any required N/A..... feet

Ground surface elevation feet MSI.

This Authorization Expires10-23-85.....

Approved By 4-23-85 *FE*

I certify that we will comply with K.S.A. 55-101, et seq., plus eventually plugging hole to K.C.C. specifications.

Date 9-19-85 Signature of Operator or Agent _____


Title

Form C-1 4/84

МНС/КОНЕ 4-23-85

Must be filed with the K.C.C. five (5) days prior to commencing well
This card void if drilling not started within six (6) months of date received by K.C.C.

A Regular Section of Land
1 Mile = 5,280 Ft.

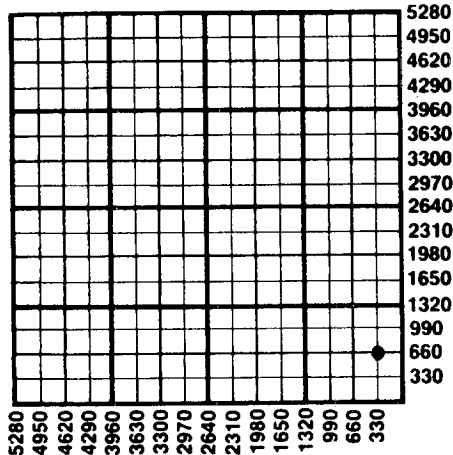

Important procedures to follow:

1. Notify District office before setting surface casing.
2. Set surface casing by circulating cement to the top.
3. File completion forms ACO-1 with K.C.C. within 90 days of well completion, following instructions on ACO-1, side 1, and including copies of wireline logs.
4. Notify District office 48 hours prior to old well workover or re-entry.
5. Prior to plugging, prepare a plugging plan, then obtain agreement from the appropriate district office for an approved plugging plan.
6. Submit plugging report (CP-4) to K.C.C. after plugging is completed.
7. Obtain an approved injection docket number before disposing of salt water.
8. Notify K.C.C. within 10 days when injection commences or terminates.
9. If an alternate 2 completion, cement in the production pipe from below any usable water to surface within 120 days of spud date.

State Corporation Commission of Kansas
Conservation Division
200 Colorado Derby Building
Wichita, Kansas 67202
(316) 263-3238