

CARD MUST BE TYPED

State of Kansas  
**NOTICE OF INTENTION TO DRILL**

*Correction*  
CARD MUST BE SIGNED

(see rules on reverse side)

**CORRECTED SPOT LOCATION**

1-18-85

Starting Date: ..... 1 ..... 22 ..... 85 .....  
month day year

API Number 15, 163-22, 615 - 00 - 00  
160' N & 160' W of

OPERATOR: License # .....  
BOESE BROTHERS

C NW NE  East  
..... Sec. 17. Twp. 9. S, Rge. 19W  West

Name .....  
Address Monument, Kansas 67747

(location) \* 4780  
..... Ft North from Southeast Corner of Section

City/State/Zip .....

..... 2140 ..... Ft West from Southeast Corner of Section

Contact Person ..... Galen Boese

(Note: Locate well on Section Plat on reverse side)

Phone ..... 913-672-3545

Nearest lease or unit boundary line ..... 500 ..... feet.

CONTRACTOR: License # ..... 5302

County ..... Rooks

Name ..... Red Tiger Drilling Company

Lease Name ..... Heronome ..... Well# #1-A

City/State ..... Wichita, Kansas 67202

Well Drilled For: Well Class: Type Equipment:  
 Oil  Swd  Infield  Mud Rotary  
 Gas  Inj  Pool Ext.  Air Rotary  
 OWWO  Expl  Wildcat  Cable

Domestic well within 330 feet:  yes  no  
Municipal well within one mile:  yes  no

If OWWO: old well info as follows:

Operator .....  
Well Name .....  
Comp Date ..... Old Total Depth .....  
Projected Total Depth ..... 3500 ..... feet  
Projected Formation at TD ..... Arbuckle  
Expected Producing Formations ..... Arbuckle

Depth to Bottom of fresh water ..... 100 ..... feet  
Lowest usable water formation ..... Dakota  
Depth to Bottom of usable water ..... 925 ..... feet  
Surface pipe by Alternate: 1  2   
Surface pipe to be set ..... 250 ..... feet  
Conductor pipe if any required ..... N. / A ..... feet  
Ground surface elevation ..... 2065Gr ..... feet MSL  
This Authorization Expires ..... 7-14-85  
Approved By ..... 1-14-85

I certify that we will comply with K.S.A. 55-101, et seq., plus eventual plugging hole to K.C.C. specifications.

*George A. Angle* owner

Texas 4620 FSL

Date 1/18/85 Signature of Operator or Agent

Title

RECEIVED  
STATE CORPORATION COMMISSION

Must be filed with the K.C.C. five (5) days prior to commencing well  
This card void if drilling not started within six (6) months of date received by K.C.C.


1/18/85  
JAN 19 1985

CONSERVATION DIVISION

WICHITA, KANSAS

A Regular Section of Land

1 Mile = 5,280 Ft.

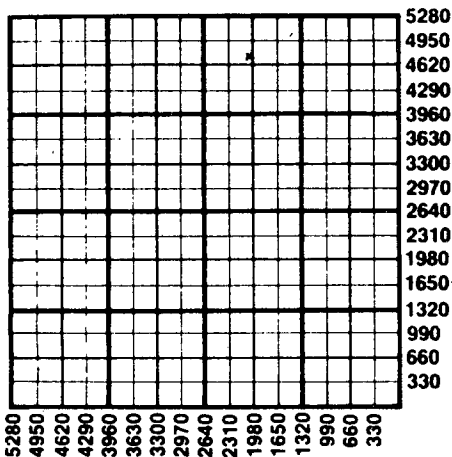

**Important procedures to follow :**

1. Notify District office before setting surface casing.
2. Set surface casing by circulating cement to the top.
3. File completion forms ACO-1 with K.C.C. within 90 days of well completion, following instructions on ACO-1, side 1, and including copies of wireline logs.
4. Notify District office 48 hours prior to old well workover or re-entry.
5. Prior to plugging, prepare a plugging plan, then obtain agreement from the appropriate district office for an approved plugging plan.
6. Submit plugging report (CP-4) to K.C.C. after plugging is completed.
7. Obtain an approved injection docket number before disposing of salt water.
8. Notify K.C.C. within 10 days when injection commences or terminates.
9. If an alternate 2 completion, cement in the production pipe from below any usable water to surface within 120 days of spud date.

State Corporation Commission of Kansas

Conservation Division

200 Colorado Derby Building

Wichita, Kansas 67202

(316) 263-3238