

CARD MUST BE TYPED
Corrected

State of Kansas
NOTICE OF INTENTION TO DRILL

CARD MUST BE SIGNED

Collection

(see rules on reverse side)

Starting Date Nov. 17, 1988
month day year

API Number 15— 037-21,388-00-00 ⁴⁻⁹⁻⁸⁷

OPERATOR: License # 8462

~~SE~~ NW NW Sec. 3 Twp. 31 S, Rg. 22 East

Name Loren Smith

5100 Ft. from South Line of Section

Address Rt. 1 Box 198

* 4160 Ft. from East Line of Section

City/State/Zip Oswego, KS 67356

(Note: Locate well on Section Plat on reverse side)

Contact Person Loren Smith

Nearest lease or unit boundary line 180 feet

Phone 316-827-6264

County Crawford

CONTRACTOR: License # 8462

Lease Name Byron Diel Well # 20

Name Loren Smith

Ground surface elevation 481 feet MSL

City/State Oswego, KS

Domestic well within 330 feet: —yes *no

Well Drilled For: Well Class: Type Equipment:

Municipal well within one mile: —yes *no

* Oil — SWD — Infield — Mud Rotary

Depth to bottom of fresh water 100

— Gas — Inj — Pool Ext. — Air Rotary

Depth to bottom of usable water 100

— OWWO — Expl * Wildcat * Cable

Surface pipe by Alternate: 1 — 2 *

If OWWO: old well info as follows:

Surface pipe planned to be set 20

Operator

Conductor pipe required none

Well Name

Projected Total Depth 215 feet

Comp Date Old Total Depth.....

Formation Bartlesville

I certify that well will comply with K.S.A. 55-101, et seq., plus eventually plugging hole to KCC specifications.

Date 11/16/88 Signature of Operator or Agent Loren Smith Title Owner

For KCC Use:

Conductor Pipe Required feet: Minimum Surface Pipe Required 20 feet per Alt. 2

This Authorization Expires 5-18-87 Approved By 11-18-88

was 4800 FEL


NW NW NW

Must be filed with the K.C.C. five (5) days prior to commencing well
This card void if drilling not started within six (6) months of date received by K.C.C.

Important procedures to follow:

1. Notify District office before setting surface casing.
2. Set surface casing by circulating cement to the top.
3. File completion forms ACO-1 with K.C.C. within 90 days of well completion, following instructions on ACO-1, side 1, and including copies of wireline logs.
4. Notify District office 48 hours prior to old well workover or re-entry.
5. Prior to filing Intent, prepare a proposed plugging plan in case well is D & A, then obtain approval of plan when calling district office prior to setting surface pipe.
6. Submit plugging report (CP-4) to K.C.C. after plugging is completed.
7. Obtain an approved injection docket number before disposing of salt water.
8. Notify K.C.C. within 10 days when injection commences or terminates.
9. If an alternate 2 completion, cement in the production pipe from below any usable water to surface within 120 days of spud date.

**A Regular Section of Land
1 Mile = 5,280 Ft.**

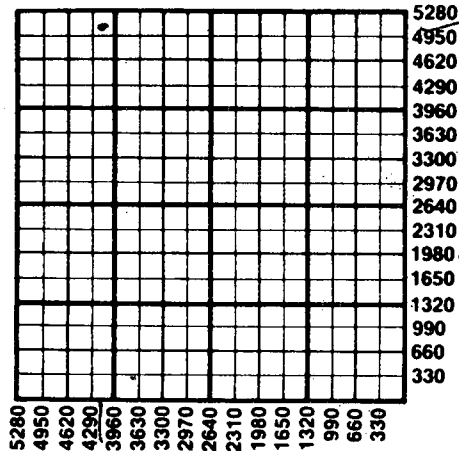

APR 9 1987

4-9-87

State Corporation Commission of Kansas
Conservation Division
200 Colorado Derby Building
Wichita, Kansas 67202
(316) 263-3238