

CARD MUST BE TYPED

State of Kansas  
**NOTICE OF INTENTION TO DRILL**  
(see rules on reverse side)

CARD MUST BE SIGNED

Starting Date: 4-16-85  
month day year

OPERATOR: License # 9015  
Name INCO Energy Inc.  
Address P. O. Box 379  
City/State/Zip Parsons, Ks. 67357  
Contact Person Ken Johnson  
Phone 316-421-0910

CONTRACTOR: License #  
Name  
City/State

Well Drilled For:	Well Class:	Type Equipment:
<input checked="" type="checkbox"/> Oil	<input checked="" type="checkbox"/> Infield	<input type="checkbox"/> Mud Rotary
<input type="checkbox"/> Gas	<input type="checkbox"/> Pool Ext.	<input type="checkbox"/> Air Rotary
<input type="checkbox"/> OWWO	<input type="checkbox"/> Wildcat	<input type="checkbox"/> Cable

If OWWO: old well info as follows:

Operator  
Well Name  
Comp Date Old Total Depth  
Projected Total Depth 250 feet  
Projected Formation at TD Skinner SD  
Expected Producing Formations

I certify that we will comply with K.S.A. 55-101, et seq., plus eventually plugging hole to K.C.C. specifications.

Date 4/11/85 Signature of Operator or Agent

API Number 15-

099-12,326-00-00

NW NW NE Sec 3 Twp 31 S, Rge 21  
(location)

4639 Ft North from Southeast Corner of Section  
2622 Ft West from Southeast Corner of Section  
(Note: Locate well on Section Plat on reverse side)

Nearest lease or unit boundary line 1310 feet.  
County Labette  
Lease Name Devlin Well# 63

Domestic well within 330 feet: ☐ yes ☒ no  
Municipal well within one mile: ☐ yes ☒ no

Depth to Bottom of fresh water 20 feet  
Lowest usable water formation Surface  
Depth to Bottom of usable water 150 feet  
Surface pipe by Alternate: 1 ☐ 2 ☒  
Surface pipe to be set 20 feet  
Conductor pipe if any required - feet  
Ground surface elevation 840 feet MSL  
This Authorization Expires 10-12-85  
Approved By 4-12-85

Title PROD SUPER


Form C-1 4/84

MHC/UDHE 4-12-85

Must be filed with the K.C.C. five (5) days prior to commencing well  
This card void if drilling not started within six (6) months of date received by K.C.C.

**Important procedures to follow :**

**A Regular Section of Land**  
**1 Mile = 5,280 Ft.**

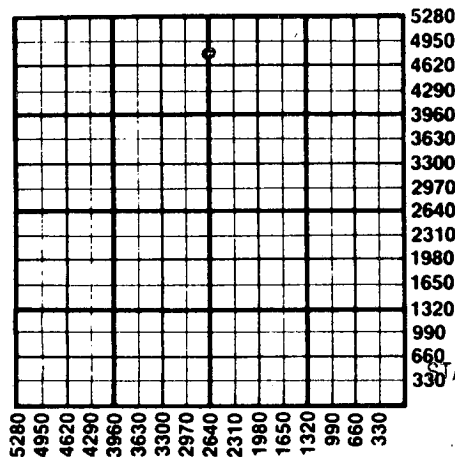

1. Notify District office before setting surface casing.
2. Set surface casing by circulating cement to the top.
3. File completion forms ACO-1 with K.C.C. within 90 days of well completion, following instructions on ACO-1, side 1, and including copies of wireline logs.
4. Notify District office 48 hours prior to old well workover or re-entry.
5. Prior to plugging, prepare a plugging plan, then obtain agreement from the appropriate district office for an approved plugging plan.
6. Submit plugging report (CP-4) to K.C.C. after plugging is completed.
7. Obtain an approved injection docket number before disposing of salt water.
8. Notify K.C.C. within 10 days when injection commences or terminates.
9. If an alternate 2 completion, cement in the production pipe from below any usable water to surface within 120 days of spud date.

RECEIVED

STATE CORPORATION COMMISSION

APR 12 1985

State Corporation Commission of Kansas

Conservation Division

200 Colorado Derby Building

Wichita, Kansas 67202

(316) 263-3238

CONSERVATION DIVISION  
Wichita, Kansas

4-12-85