

CARD MUST BE TYPED

State of Kansas

CARD MUST BE SIGNED

NOTICE OF INTENTION TO DRILL

(see rules on reverse side)

Expected Spud Date... April 30, 1987
 month day year

API Number 15—

099-22,561-00-00

OPERATOR: License # 4514

Name Cattleman Inc.

Address Rt. 4, Box 107J

City/State/Zip Parsons, Ks. 67357

Contact Person Kevin Hough

Phone 316-583-5202

CONTRACTOR: License # 5379

Name Kephart Drilling Inc.

City/State Box 68-A Thayer, Ks. 66776

Well Drilled For: Well Class: Type Equipment:

— Oil — Storage — Infield ☒ Mud Rotary

☒ Gas — Inj — Pool Ext. ☒ Air Rotary

— OWWO — Expl — Wildcat — Cable

If OWWO: old well info as follows:

Operator

Well Name

Comp Date Old Total Depth

I certify that well will comply with K.S.A. 55-101, et seq., plus eventually plugging hole to KCC specifications.

Date 4-22-87 Signature of Operator or Agent

For KCC Use:

Conductor Pipe Required feet; Minimum Surface Pipe Required 20 feet per Alt. 4 2

This Authorization Expires 10-24-87 Approved By 4-24-87

SE SE SW Sec 5 Twp 31 S, Rg 21

330

Ft. from South Line of Section

3280

Ft. from East Line of Section

(Note: Locate well on Section Plat on reverse side)

Nearest lease or unit boundary line 330 feet

County Labette

Lease Name Cattleman Well # 2-S

Ground surface elevation 840 feet MSL

Domestic well within 330 feet: —yes ☒ noMunicipal well within one mile: —yes ☒ no

Depth to bottom of fresh water 20'

Depth to bottom of usable water 100'

Surface pipe by Alternate: 1 — 2 ☒

Surface pipe planned to be set 20'

Conductor pipe required

Projected Total Depth 600 feet

Formation Mississippi


Title

Must be filed with the K.C.C. five (5) days prior to commencing well
This card void if drilling not started within six (6) months of date received by K.C.C.

Important procedures to follow:

1. Notify District office before setting surface casing.
2. Set surface casing by circulating cement to the top.
3. File completion forms ACO-1 with K.C.C. within 120 days of well spud date, following instructions on ACO-1, side 1, and including copies of wireline logs.
4. Notify District office 48 hours prior to old well workover or re-entry.
5. Prior to filing Intent, prepare a proposed plugging plan in case well is D & A, then obtain approval of plan when calling district office prior to setting surface pipe.
Submit plugging report (CP-4) to K.C.C. after plugging is completed.
Obtain an approved injection docket number before disposing of salt water.
8. Notify K.C.C. within 10 days when injection commences or terminates.
9. If an alternate 2 completion, cement in the production pipe from below any usable water to surface within 120 days of spud date.

A Regular Section of Land 1 Mile = 5,280 Ft.

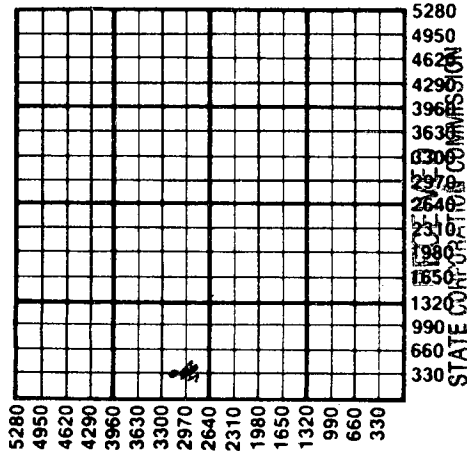

APR 24 1987

CONSERVATION DIVISION
Wichita, Kansas

State Corporation Commission of Kansas
Conservation Division
200 Colorado Derby Building
Wichita, Kansas 67202-1212
(316) 263-3238