

CARD MUST BE TYPED

State of Kansas

CARD MUST BE SIGNED

NOTICE OF INTENTION TO DRILL

(see rules on reverse side)

Expected Spud Date. June 17, 1988
month day year

API Number 15— 099-22,708-00-00

OPERATOR: License # 4514
 Name Cattlemans Inc.
 Address Route 4, Box 107J
 City/State/Zip Parsons, Kansas 67357
 Contact Person Kevin F. Hough
 Phone (316) 583-7571

CONTRACTOR: License # 5379
 Name Kephart Drilling Inc.
 City/State Thayer, Kansas 66776

Well Drilled For: Well Class: Type Equipment:
 ___ Oil ___ Storage ___ Infield ___ Mud Rotary
X Gas ___ Inj ___ Pool Ext. X Air Rotary
 ___ OWWO ___ Expl X Wildcat ___ Cable

If OWWO: old well info as follows:

Operator _____
 Well Name _____
 Comp Date _____ Old Total Depth _____






Appx. C SW SW Sec. 5 Twp. 31 S, Rg. 21 X East
 660 Ft. from South Line of Section
 4620 Ft. from East Line of Section

(Note: Locate well on Section Plat on reverse side)

Nearest lease or unit boundary line 660 feet
 County Labette

Lease Name Cattleman Well # 6-S

Ground surface elevation 840 feet MSL

Domestic well within 330 feet: ___ yes X noMunicipal well within one mile: ___ yes X no

Depth to bottom of fresh water 20'

Depth to bottom of usable water 100'

Surface pipe by Alternate: 1 ___ 2 ___

Surface pipe planned to be set 20'

Conductor pipe required N/A

Projected Total Depth 600' feet

Formation Mississippi

I certify that well will comply with K.S.A. 55-101, et seq., plus eventually plugging hole to KCC specifications.

Date 6-7-88 Signature of Operator or Agent _____ Title Contractor

For KCC Use:

Conductor Pipe Required _____ feet; Minimum Surface Pipe Required _____ feet per Alt. 20

This Authorization Expires 12-13-88 Approved By RCH 6-13-88


EFFECTIVE DATE: 6-18-88

Must be filed with the K.C.C. five (5) days prior to commencing well
This card void if drilling not started within six (6) months of date received by K.C.C.

Important procedures to follow:

1. Notify District office before setting surface casing.
 2. Set surface casing by circulating cement to the top.
 3. File completion forms ACO-1 with K.C.C. within 120 days of well spud date, following instructions on ACO-1, side 1, and including copies of wireline logs.
 4. Notify District office 48 hours prior to old well workover or re-entry.
 5. Prior to filing Intent, prepare a proposed plugging plan in case well is D & A, then obtain approval of plan when calling district office prior to setting surface pipe.
 6. Submit plugging report (CP-4) to K.C.C. after plugging is completed.
 7. Obtain an approved injection docket number before disposing of salt water.
8. Notify K.C.C. within 10 days when injection commences or terminates.

A Regular Section of Land 1 Mile = 5,280 Ft.

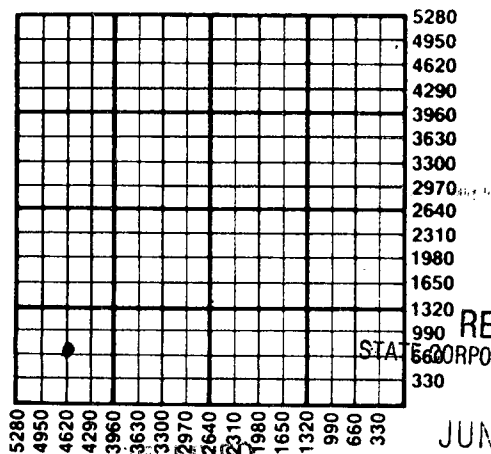

RECEIVED

STATE CORPORATION COMMISSION

JUN - 8 1988

STATE CORPORATION COMMISSION

JUN 13 1988

CONSERVATION DIVISION

CONSERVATION DIVISION
Wichita, Kansas

6-13-88

If an alternate 2 completion, cement in the production pipe from below any usable water to surface within 120 days of spud date.

State Corporation Commission of Kansas
Conservation Division
200 Colorado Derby Building
Wichita, Kansas 67202-1212
(316) 263-3238