

CARD MUST BE TYPED

State of Kansas
NOTICE OF INTENTION TO DRILL
(see rules on reverse side)

CARD MUST BE SIGNED

Starting Date: Aug. 8 1985.
month day year

API Number 15- 099-22,363-0000

OPERATOR: License # 7330
Name John T. Smith
Address 267 7th Ave. So.
City/State/Zip Columbus, NEB 68601
Contact Person Bill Bumgarner
Phone 316-565-2220

NE SWNW (location) Sec. 36 Twp 32. S, Rge. 17 East West

3630 Ft North from Southeast Corner of Section
4290 Ft West from Southeast Corner of Section
(Note: Locate well on Section Plat on reverse side)

CONTRACTOR: License # unknown
Name
City/State

Nearest lease or unit boundary line 330 feet.
County Labette
Lease Name Myers Well# 2

Well Drilled For: Well Class: Type Equipment:
 Oil Swd Infield Mud Rotary
 Gas Inj Pool Ext. Air Rotary
 OWWO Expl Wildcat Cable

Domestic well within 330 feet : yes no
Municipal well within one mile : yes no

If OWWO: old well info as follows:

Operator
Well Name
Comp Date Old Total Depth
Projected Total Depth 1000 feet
Projected Formation at TD Mississippi
Expected Producing Formations Barts. & Miss.

Depth to Bottom of fresh water 40 feet
Lowest usable water formation unknown
Depth to Bottom of usable water 100 feet
Surface pipe by Alternate : 1 2
Surface pipe to be set 20 feet
Conductor pipe if any required none feet
Ground surface elevation unknown feet MSL
This Authorization Expires 2-5-86
Approved By 8-5-85 K. Pitt for Korte.


I certify that we will comply with K.S.A. 55-101, et seq., plus eventually plugging hole to K.C.C. specifications.

Date 7-31-85 Signature of Operator or Agent Bill Bumgarner Title agent

Must be filed with the K.C.C. five (5) days prior to commencing well
 This card void if drilling not started within six (6) months of date received by K.C.C.

Important procedures to follow :

A Regular Section of Land
1 Mile = 5,280 Ft.

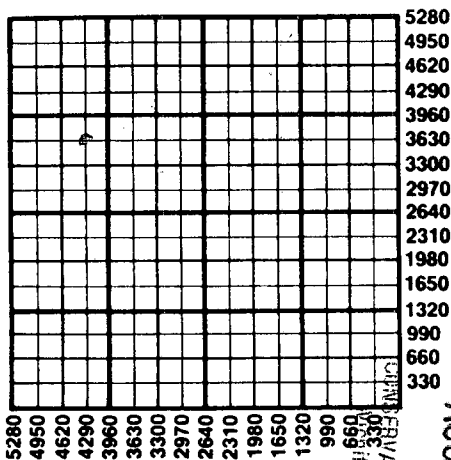

CONSERVATION DIVISION,
 State Corporation Commission,
 Wichita, Kansas

AUG 5 1985

RECEIVED
 STATE CORPORATION COMMISSION

1. Notify District office before setting surface casing.
2. Set surface casing by circulating cement to the top.
3. File completion forms ACO-1 with K.C.C. within 90 days of well completion, following instructions on ACO-1, side 1, and including copies of wireline logs.
4. Notify District office 48 hours prior to old well workover or re-entry.
5. Prior to plugging, prepare a plugging plan, then obtain agreement from the appropriate district office for an approved plugging plan.
6. Submit plugging report (CP-4) to K.C.C. after plugging is completed.
7. Obtain an approved injection docket number before disposing of salt water.
8. Notify K.C.C. within 10 days when injection commences or terminates.
9. If an alternate 2 completion, cement in the production pipe from below any usable water to surface within 120 days of spud date.

State Corporation Commission of Kansas
 Conservation Division
 200 Colorado Derby Building
 Wichita, Kansas 67202
 (316) 263-3238

Handwritten signature or initials