

CARD MUST BE TYPED

State of Kansas

CARD MUST BE SIGNED

# NOTICE OF INTENTION TO DRILL

(see rules on reverse side)

Starting Date ..... 5 7 86  
month day year

API Number 15— 099-22,467-00-00

OPERATOR: License # ..... 9313  
Name James Lorenz  
Address R. R. 2  
City/State/Zip Parson, Kansas 67537  
Contact Person Jim Lorenz  
Phone 316-331-8191

..... app. SE SE NE Sec. 29 Twp. 32 S, Rg. 18  
..... 2950 Ft. from South Line of Section  
..... 330 Ft. from East Line of Section

(Note: Locate well on Section Plat on reverse side)

CONTRACTOR: License # ..... 5675  
Name McPherson Drilling Co.  
City/State R. 2, Box 221, Cherryvale, Ks. 67335

Nearest lease or unit boundary line ..... 330 feet  
County Labette

Lease Name Ellison Well # 2

Ground surface elevation ..... na feet MSL

Domestic well within 330 feet: \_\_\_\_\_ yes  no

Municipal well within one mile: \_\_\_\_\_ yes  no

Depth to bottom of fresh water ..... 20

Depth to bottom of usable water ..... 150

Surface pipe by Alternate: 1 \_\_\_\_\_ 2

Surface pipe planned to be set ..... 20

Conductor pipe required .....

Projected Total Depth ..... 800 feet

Formation Bartlesville

Well Drilled For: Well Class: Type Equipment:  
 Oil  SWD  Infield  Mud Rotary  
 Gas  Inj  Pool Ext.  Air Rotary  
 OWWO  Expl  Wildcat  Cable

If OWWO: old well info as follows:

Operator .....

Well Name .....

Comp Date ..... Old Total Depth .....

I certify that well will comply with K.S.A. 55-101, et seq., plus eventually plugging hole to KCC specifications.

Date 5-6-86 Signature of Operator or Agent *Nona A. Moore* Title as. agent

For KCC Use:

Conductor Pipe Required ..... feet; Minimum Surface Pipe Required ..... 20 feet per Alt. *80*


This Authorization Expires 11-6-86 Approved By 5-6-86 *[Signature]*

Must be filed with the K.C.C. five (5) days prior to commencing well  
This card void if drilling not started within six (6) months of date received by K.C.C.

**Important procedures to follow:**

1. Notify District office before setting surface casing.
2. Set surface casing by circulating cement to the top.
3. File completion forms ACO-1 with K.C.C. within 90 days of well completion, following instructions on ACO-1, side 1, and including copies of wireline logs.
4. Notify District office 48 hours prior to old well workover or re-entry.
5. Prior to filing Intent, prepare a proposed plugging plan in case well is D & A, then obtain approval of plan when calling district office prior to setting surface pipe.
6. Submit plugging report (CP-4) to K.C.C. after plugging is completed.
7. Obtain an approved injection docket number before disposing of salt water.
8. Notify K.C.C. within 10 days when injection commences or terminates.

**A Regular Section of Land  
1 Mile = 5,280 Ft.**

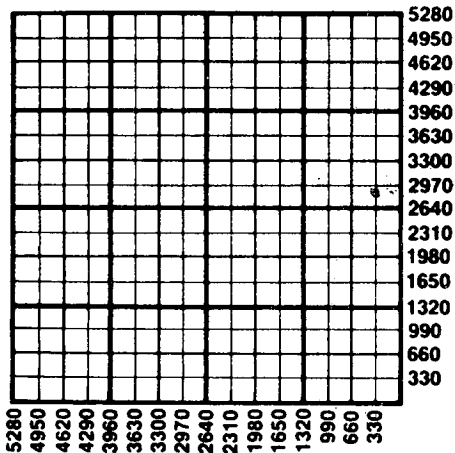

5-6-86

RECEIVED  
STATE CORPORATION COMMISSION

MAY 6 - 1986

CONSERVATION DIVISION

9. If an alternate 2 completion, cement in the production pipe from below any usable water to surface within 120 days of spud date.

State Corporation Commission of Kansas  
Conservation Division  
200 Colorado Derby Building  
Wichita, Kansas 67202  
(316) 263-3238