

CARD MUST BE TYPED

State of Kansas

CARD MUST BE SIGNED

NOTICE OF INTENTION TO DRILL

(see rules on reverse side)

Starting Date 29 July 87
month day year

API Number 15- 099-22,593-00-00 DC

OPERATOR: License # 4469
Name KELT ENERGY, INC.
Address 900 COLLEGE AVE.
City/State/Zip INDEPEDENCE, KS 67301
Contact Person PETE JOHNSON
Phone (316) 331-0207

NW SW SW NE Sec. 25 Twp. 32S S, Rg. 17E
2330 Ft. from South Line of Section
2480 Ft. from East Line of Section

(Note: Locate well on Section Plat on reverse side)

CONTRACTOR: License #
Name UNKNOWN
City/State

Nearest lease or unit boundary line 410 feet
County LABETTE

Lease Name PERRY Well # KCPP 55
Ground surface elevation 840 feet MSL

Well Drilled For: Well Class: Type Equipment:
 Oil SWD Infield Mud Rotary
 Gas Inj Pool Ext. Air Rotary
 OWWO Expl Wildcat Cable

Domestic well within 330 feet: yes no
Municipal well within one mile: yes no

If OWWO: old well info as follows:
Operator NA
Well Name
Comp Date Old Total Depth

Depth to bottom of fresh water
Depth to bottom of usable water 200
Surface pipe by Alternate: 1 2
Surface pipe planned to be set 20
Conductor pipe required NA
Projected Total Depth 700 feet
Formation BARTLESVILLE

I certify that well will comply with K.S.A. 55-101, et seq., plus eventually plugging hole to KCC specifications.

Date 24 July 87 Signature of Operator or Agent P. Johnson Title AGENT

For KCC Use:


Conductor Pipe Required _____ feet; Minimum Surface Pipe Required 20 feet per Alt. 2
This Authorization Expires 1-27-88 Approved By Pet. 7-27-87

Must be filed with the K.C.C. five (5) days prior to commencing well
This card void if drilling not started within six (6) months of date received by K.C.C.

Important procedures to follow:

1. Notify District office before setting surface casing.
2. Set surface casing by circulating cement to the top.
3. File completion forms ACO-1 with K.C.C. within 90 days of well completion, following instructions on ACO-1, side 1, and including copies of wireline logs.
4. Notify District office 48 hours prior to old well workover or re-entry.
Prior to filing Intent, prepare a proposed plugging plan in case well is D & A, then obtain approval of plan when calling district office prior to setting surface pipe.
5. Submit plugging report (CP-4) to K.C.C. after plugging is completed.
7. Obtain an approved injection docket number before disposing of salt water.
8. Notify K.C.C. within 10 days when injection commences or terminates.
9. If an alternate 2 completion, cement in the production pipe from below any usable water to surface within 120 days of spud date.

A Regular Section of Land 1 Mile = 5,280 Ft.

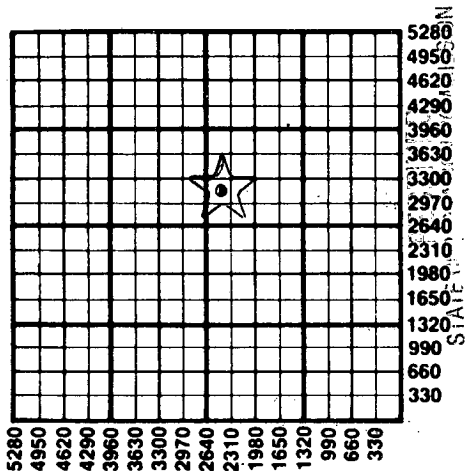

JUL 27 1987

CONSERVATION DIVISION
Wichita, Kansas

7-27-87

State Corporation Commission of Kansas
Conservation Division
200 Colorado Derby Building
Wichita, Kansas 67202
(316) 263-3238