

**CORRECTION**

**CORRECTED**

CARD MUST BE TYPED

**NOTICE OF INTENTION TO DRILL**

CARD MUST BE SIGNED

(see rules on reverse side)

Starting Date: July 6, 1984  
month day year

API Number 15- 099-21,984-0000 <sup>1-29-85</sup>

OPERATOR: License # 7406  
Name BACH Corporation  
Address P.O. Box 383  
City/State/Zip Cherryvale, KS 67335  
Contact Person J. Steve Black  
Phone (316) 336-3947

\*NW. NE NE Sec. 26. Twp 32. S, Rge 17.  East  West  
(location)

\* 4920 Ft North from Southeast Corner of Section  
\* 970 Ft West from Southeast Corner of Section  
(Note: Locate well on Section Plat on reverse side)

CONTRACTOR: License #  
Name K&J Drilling  
City/State Bartlett KS

Nearest lease or unit boundary line 450 feet.  
County Labette  
Lease Name C.L. Spradling Well# 60

Well Drilled For: Well Class: Type Equipment:  
 Oil  Swd  Infield  Mud Rotary  
 Gas  Inj  Pool Ext.  Air Rotary  
 OWWO  Expl  Wildcat  Cable

Domestic well within 330 feet:  yes  no  
Municipal well within one mile:  yes  no

If OWWO: old well info as follows:  
Operator  
Well Name  
Comp Date Old Total Depth  
Projected Total Depth 1350 feet  
Projected Formation at TD Arbuckle  
Expected Producing Formations Bartlesville

Depth to Bottom of fresh water Unknown feet  
Lowest usable water formation Unknown  
Depth to Bottom of usable water 200 feet  
Surface pipe by Alternate: 1  2   
Surface pipe to be set 20+ feet  
Conductor pipe if any required  
Ground surface elevation 785 feet MSL  
This Authorization Expires 8-2-84  
Approved By 2-2-84


I certify that we will comply with K.S.A. 55-101, et seq., plus eventually plugging hole to K.C.C. specifications. 2005 NW 3030 FSL

Date 1-24-85 Signature of Operator or Agent J. Steve Black Title N.P. Engineering  
3530 FEL

Must be filed with the K.C.C. five (5) days prior to commencing well  
 This card void if drilling not started within six (6) months of date received by K.C.C.

**Important procedures to follow :**

**A Regular Section of Land  
 1 Mile = 5,280 Ft.**

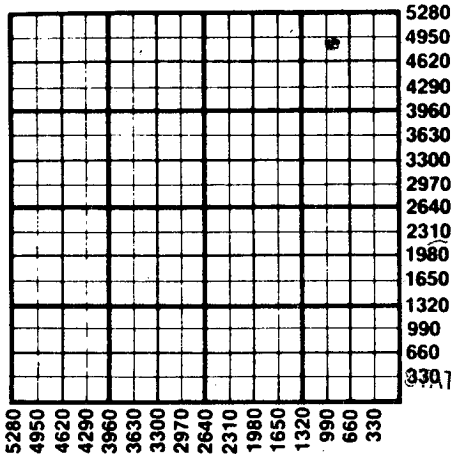

1. Notify District office before setting surface casing.
2. Set surface casing by circulating cement to the top.
3. File completion forms ACO-1 with K.C.C. within 90 days of well completion, following instructions on ACO-1, side 1, and including copies of wireline logs.
4. Notify District office 48 hours prior to old well workover or re-entry.
5. Prior to plugging, prepare a plugging plan, then obtain agreement from the appropriate district office for an approved plugging plan.
6. Submit plugging report (CP-4) to K.C.C. after plugging is completed.
7. Obtain an approved injection docket number before disposing of salt water.
8. Notify K.C.C. within 10 days when injection commences or terminates.

9. If an alternate 2 completion, cement in the production pipe from below any usable water to surface within 120 days of spud date.

RECEIVED

STATE CORPORATION COMMISSION

129-58

JAN 29 1985

CONSERVATION DIVISION  
 Wichita, Kansas

State Corporation Commission of Kansas  
 Conservation Division  
 200 Colorado Derby Building  
 Wichita, Kansas 67202  
 (316) 263-3238