

NOTICE OF INTENTION TO DRILL

(see rules on reverse side)

Starting Date 2 27 1986 month day year

API Number 15- 099-22,429-00-00

OPERATOR: License # 9313

app. SW SW SE Sec. 20 Twp. 32 S, Rg. 18 East West
440 Ft. from South Line of Section
2200 Ft. from East Line of Section

Name Jim Lorenze

Address R.R. 2

City/State/Zip Parsons, Kansas 67357

Contact Person Rayma

Phone 316-331-8191

CONTRACTOR: License # 5675

(Note: Locate well on Section Plat on reverse side)
Nearest lease or unit boundary line 440 feet
County Labette
Lease Name Fleming Well # 1

Name McPherson Drilling Co.

City/State Route 2, Box 221, Cherryvale, KS 67335

Well Drilled For: Well Class: Type Equipment:

Ground surface elevation feet MSL
Domestic well within 330 feet: yes X no
Municipal well within one mile: yes X no
Depth to bottom of fresh water 20
Depth to bottom of usable water 100-150
Surface pipe by Alternate: 1 2 X
Surface pipe planned to be set 20
Conductor pipe required
Projected Total Depth 800 feet
Formation

X Oil SWD Infield Mud Rotary
X Gas Inj Pool Ext. X Air Rotary
OWWO Expl Wildcat Cable

If OWWO: old well info as follows:

Operator

Well Name

Comp Date Old Total Depth

I certify that well will comply with K.S.A. 55-101, et seq., plus eventually plugging hole to KCC specifications.

Date 2/27/86 Signature of Operator or Agent Sherril Bohan Title as agent

For KCC Use:

Conductor Pipe Required feet; Minimum Surface Pipe Required 20 feet per Alt. X 2

This Authorization Expires 8-27-86 Approved By 2-27-86


Handwritten signatures and initials, including 'Pett/DH' and a circled '2'.

Must be filed with the K.C.C. five (5) days prior to commencing well
This card void if drilling not started within six (6) months of date received by K.C.C.

Important procedures to follow:

1. Notify District office before setting surface casing.
2. Set surface casing by circulating cement to the top.
3. File completion forms ACO-1 with K.C.C. within 90 days of well completion, following instructions on ACO-1, side 1, and including copies of wireline logs.
4. Notify District office 48 hours prior to old well workover or re-entry.
5. Prior to filing Intent, prepare a proposed plugging plan in case well is D & A, then obtain approval of plan when calling district office prior to setting surface pipe.
6. Submit plugging report (CP-4) to K.C.C. after plugging is completed.
7. Obtain an approved injection docket number before disposing of salt water.
8. Notify K.C.C. within 10 days when injection commences or terminates.
9. If an alternate 2 completion, cement in the production pipe from below any usable water to surface within 120 days of spud date.

A Regular Section of Land
1 Mile = 5,280 Ft.

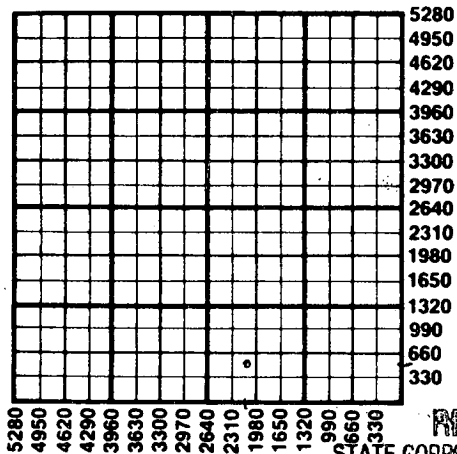

RECEIVED

STATE CORPORATION COMMISSION

2-27-86

FEB 27 1986

CONSERVATION DIVISION
Wichita, Kansas

State Corporation Commission of Kansas
Conservation Division
200 Colorado Derby Building
Wichita, Kansas 67202
(316) 263-3238