

CARD MUST BE TYPED

State of Kansas

CARD MUST BE SIGNED

NOTICE OF INTENTION TO DRILL

(see rules on reverse side)

Starting Date 8-2-85
month day yearOPERATOR: License # 5782
Name V W & B Drilling Co.
Address Box 7; N. Hwy 169
City/State/Zip Cherryvale, Ks., 67335
Contact Person William J. Billman
Phone 316-784-5862CONTRACTOR: License # 5782
Name V W & B Drilling Co.
City/State Cherryvale, Ks., 67335Well Drilled For: Well Class: Type Equipment:
☒ Oil ☐ SWD ☐ Infield ☐ Mud Rotary
☒ Gas ☐ Inj ☐ Pool Ext. ☒ Air Rotary
☐ OWWO ☐ Expl ☒ Wildcat ☐ Cable

If OWWO: old well info as follows:

Operator
Well Name
Comp Date Old Total Depth

I certify that well will comply with K.S.A. 55-101, et seq., plus eventually plugging hole to KCC specifications.

Alternate 3 cementing will be done immediately upon setting production casingDate .. 8-28-85 Signature of Operator or Agent W. J. Billman Title .. Agent ..

For KCC Use:

Conductor Pipe Required feet; Minimum Surface Pipe Required feet per Alt. 1 2 3This Authorization Expires 2-1-86 Approved By 8-1-85API Number 15— 099-22,361 — 00-00 CORRECTION* SE SE SW Sec. 21 Twp. 32 S, Rg. 18. — West
* 330 Ft. from South Line of Section
2970 Ft. from East Line of Section

(Note: Locate well on Section Plat on reverse side)


Nearest lease or unit boundary line 330 feet
County Labette
Lease Name Harold Winkleman Well # 1
Ground surface elevation feet MSL
Domestic well within 330 feet: — yes ☒ no
Municipal well within one mile: — yes ☒ no
Surface pipe by Alternate: 1 — 2 ☒ 3
Depth to bottom of fresh water 100
Depth to bottom of usable water 150
Surface pipe planned to be set 20
Projected Total Depth 920 feet
FormationSESE NW
2970 FSL

Must be filed with the K.C.C. five (5) days prior to commencing well
This card void if drilling not started within six (6) months of date received by K.C.C.

Important procedures to follow:

1. Notify District office before setting surface casing.
2. Set surface casing by circulating cement to the top.
3. File completion forms ACO-1 with K.C.C. within 90 days of well completion, following instructions on ACO-1, side 1, and including copies of wireline logs.
4. Notify District office 48 hours prior to old well workover or re-entry.
5. Prior to filing Intent, prepare a proposed plugging plan in case well is D & A, then obtain approval of plan when calling district office prior to setting surface pipe.
6. Submit plugging report (CP-4) to K.C.C. after plugging is completed.
7. Obtain an approved injection docket number before disposing of salt water.
8. Notify K.C.C. within 10 days when injection commences or terminates.
9. If an alternate 2 completion, cement in the production pipe from below any usable water to surface within 120 days of spud date.

A Regular Section of Land 1 Mile = 5,280 Ft.

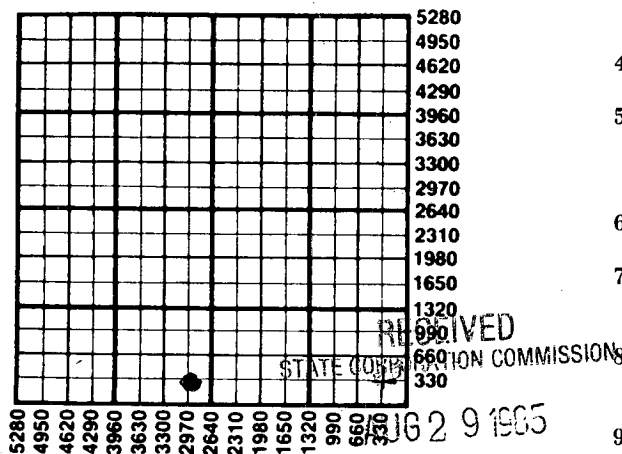

CONSERVATION DIVISION
Wichita, Kansas

8-29-85

State Corporation Commission of Kansas
Conservation Division
200 Colorado Derby Building
Wichita, Kansas 67202
(316) 263-3238