

CARD MUST BE TYPED

State of Kansas
NOTICE OF INTENTION TO DRILL

CARD MUST BE SIGNED

(see rules on reverse side)

Starting Date: 12 23 85
month day year

API Number 15- 099-22,400-0000

OPERATOR: License # KCC 4469
Name Kelt Energy
Address 300 East Main
City/State/Zip Cherryvale, KS
Contact Person Jeff Goodrich
Phone 316-336-2162

SW. NW. NE. Sec. 25 Twp 32. S, Rge 17. East West
(location)

4038 Ft North from Southeast Corner of Section
2145 Ft West from Southeast Corner of Section
(Note: Locate well on Section Plat on reverse side)

CONTRACTOR: License # Q350
Name THOMPSON DRILLING
City/State INDEPENDENCE, KS

Nearest lease or unit boundary line 220 feet.
County ~~Montgomery~~ LABETTE

Lease Name Perry Well# KDP-6

Well Drilled For: Well Class: Type Equipment:
 Oil Swd Infield Mud Rotary
 Gas Inj Pool Ext. Air Rotary
 OWWO Expl Wildcat Cable

Domestic well within 330 feet: yes no
Municipal well within one mile: yes no

If OWWO: old well info as follows:

Operator
Well Name
Comp Date Old Total Depth
Projected Total Depth 700 feet
Projected Formation at TD 650
Expected Producing Formations Bartlesville

Depth to Bottom of fresh water 50 feet
Lowest usable water formation 50
Depth to Bottom of usable water feet
Surface pipe by Alternate: 1 2
Surface pipe to be set 50 feet
Conductor pipe if any required feet
Ground surface elevation feet MSL
This Authorization Expires 6-23-86
Approved By DAS


I certify that we will comply with K.S.A. 55-101, et seq., plus eventually plugging hole to K.C.C. specifications.

Date 12-20-85 Signature of Operator or Agent Daniel Thalla DG Title Engineer

**Must be filed with the K.C.C. five (5) days prior to commencing well
This card void if drilling not started within six (6) months of date received by K.C.C.**

Important procedures to follow :

**A Regular Section of Land
1 Mile = 5,280 Ft.**

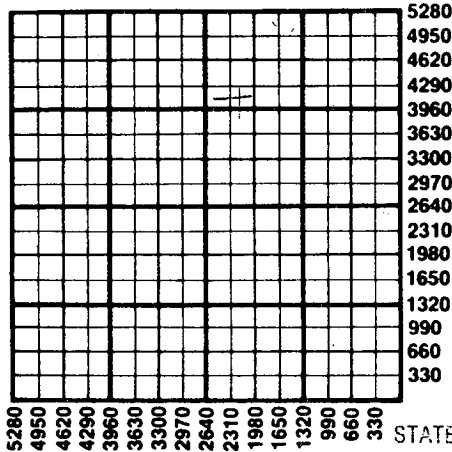

1. Notify District office before setting surface casing.
2. Set surface casing by circulating cement to the top.
3. File completion forms ACO-1 with K.C.C. within 90 days of well completion, following instructions on ACO-1, side 1, and including copies of wireline logs.
4. Notify District office 48 hours prior to old well workover or re-entry.
5. Prior to plugging, prepare a plugging plan, then obtain agreement from the appropriate district office for an approved plugging plan.
6. Submit plugging report (CP-4) to K.C.C. after plugging is completed.
7. Obtain an approved injection docket number before disposing of salt water.
8. Notify K.C.C. within 10 days when injection commences or terminates.
9. If an alternate 2 completion, cement in the production pipe from below any usable water to surface within 120 days of spud date.

STATE CORPORATION COMMISSION - State Corporation Commission of Kansas

Conservation Division

200 Colorado Derby Building

Wichita, Kansas 67202

(316) 263-3238

DEC 23 1985

12-23-85

CONSERVATION DIVISION

Wichita, Kansas