

NOTICE OF INTENTION TO DRILL

(see rules on reverse side)

Starting Date January 30, 1986 month day year

API Number 15-099-22,416-00000

OPERATOR: License # 4469 Name Kelt Energy, Inc. Address c/o Holiday Inn, Rm 118 City/State/Zip Chanute, KS 66720 Contact Person Don Gralla Phone (316) 336-2162

app NE SW NE Sec 25 Twp 32 S Rg 17 3378 Ft. from South Line of Section 1815 Ft. from East Line of Section

(Note: Locate well on Section Plat on reverse side)

CONTRACTOR: License # 9350 Name Thompson Drilling Co., Inc. City/State Independence, KS 67301

Nearest lease or unit boundary line 825 feet County Labette Lease Name Perry Well # KDP-20

Well Drilled For: Oil SWD Infield Gas Inj Pool Ext OWWO Expl Wildcat Type Equipment: Mud Rotary Air Rotary Cable

Ground surface elevation na feet MSL Domestic well within 330 feet: yes no Municipal well within one mile: yes no

If OWWO: old well info as follows: Operator Well Name Comp Date Old Total Depth

Depth to bottom of fresh water 50 Depth to bottom of usable water 50-200 Surface pipe by Alternate 2 ft Surface pipe planned to be set 20 Conductor pipe required Projected Total Depth 700 Formation Bartlesville

I certify that well will comply with K.S.A. 55-101, et seq., plus eventually plugging hole to KCC specifications. Date 1/30/86 Signature of Operator or Agent Title As Agent


For KCC Use: Conductor Pipe Required feet; Minimum Surface Pipe Required 20 feet per Alt. This Authorization Expires 7-30-86 Approved By 1-30-86

Must be filed with the K.C.C. five (5) days prior to commencing well  
This card void if drilling not started within six (6) months of date received by K.C.C.

**Important procedures to follow:**

1. Notify District office before setting surface casing.
2. Set surface casing by circulating cement to the top.
3. File completion forms ACO-1 with K.C.C. within 90 days of well completion, following instructions on ACO-1, side 1, and including copies of wireline logs.
4. Notify District office 48 hours prior to old well workover or re-entry.
5. Prior to filing Intent, prepare a proposed plugging plan in case well is D & A, then obtain approval of plan when calling district office prior to setting surface pipe.
6. Submit plugging report (CP-4) to K.C.C. after plugging is completed.
7. Obtain an approved injection docket number before disposing of salt water.
8. Notify K.C.C. within 10 days when injection commences or terminates.
9. If an alternate 2 completion, cement in the production pipe from below any usable water to surface within 120 days of spud date.

**A Regular Section of Land  
1 Mile = 5,280 Ft.**

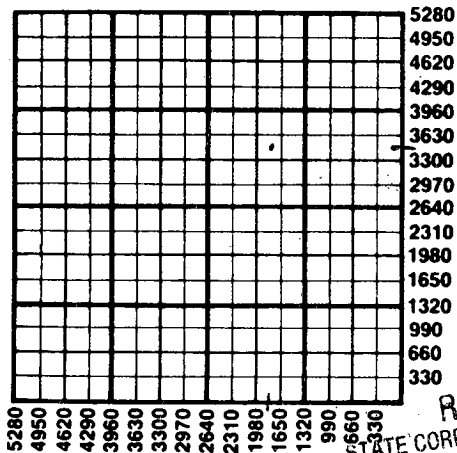

RECEIVED

STATE CORPORATION COMMISSION

JAN 30 1986

CONSERVATION DIVISION  
Wichita, Kansas

1-30-86

State Corporation Commission of Kansas  
Conservation Division  
200 Colorado Derby Building  
Wichita, Kansas 67202  
(316) 263-3238