

NOTICE OF INTENTION TO DRILL

(see rules on reverse side)

Starting Date ..... Aug. 08, 1986 .....  
month day year 10:55

API Number 15— 099-22,494-00-000

OPERATOR: License # 4469  
Name Kelt Energy, Inc.  
Address 900 College Street  
City/State/Zip Independence, Kansas 67301  
Contact Person Bob Blythe  
Phone (316) 331-0207

App. SW SE NE Sec. 25 Twp. 32 S, Rg. 17  
3048 Ft. from South Line of Section  
1155 Ft. from East Line of Section

—X East  
— West

(Note: Locate well on Section Plat on reverse side)

CONTRACTOR: License # 9350  
Name Thompson Drilling Co., Inc.  
City/State Box 605, Independence, KS 67301

Nearest lease or unit boundary line 1155 feet  
County Montgomery ~~Labette~~  
Lease Name Perry Well # KDP-31  
Ground surface elevation n/a feet MSL

Well Drilled For: Well Class: Type Equipment:  
X Oil — SWD — Infield —X Mud Rotary  
— Gas — Inj X Pool Ext. — Air Rotary  
— OWWO — Expl — Wildcat — Cable

Domestic well within 330 feet: —yes X no  
Municipal well within one mile: —yes X no  
Depth to bottom of fresh water 50  
Depth to bottom of usable water 150 ~~200~~  
Surface pipe by Alternate: 1 — 2 X  
Surface pipe planned to be set 20  
Conductor pipe required n/a  
Projected Total Depth 1050 feet  
Formation Bartlesville

If OWWO: old well info as follows:

Operator  
Well Name  
Comp Date Old Total Depth

I certify that well will comply with K.S.A. 55-101, et seq., plus eventually plugging hole to KCC specifications.

Date 9/04/86 Signature of Operator or Agent *Elaine Carlson* Title As Agent

For KCC Use:

Conductor Pipe Required ..... feet; Minimum Surface Pipe Required ..... feet per Alt. 20  
This Authorization Expires 3-4-87 Approved By 9-4-86


*PCB/KCC*

Must be filed with the K.C.C. five (5) days prior to commencing well  
This card void if drilling not started within six (6) months of date received by K.C.C.

### Important procedures to follow:

1. Notify District office before setting surface casing.
2. Set surface casing by circulating cement to the top.
3. File completion forms ACO-1 with K.C.C. within 90 days of well completion, following instructions on ACO-1, side 1, and including copies of wireline logs.
4. Notify District office 48 hours prior to old well workover or re-entry.
5. Prior to filing Intent, prepare a proposed plugging plan in case well is D & A, then obtain approval of plan when calling district office prior to setting surface pipe.
6. Submit plugging report (CP-4) to K.C.C. after plugging is completed.
7. Obtain an approved injection docket number before disposing of salt water.
8. Notify K.C.C. within 10 days when injection commences or terminates.

### A Regular Section of Land 1 Mile = 5,280 Ft.

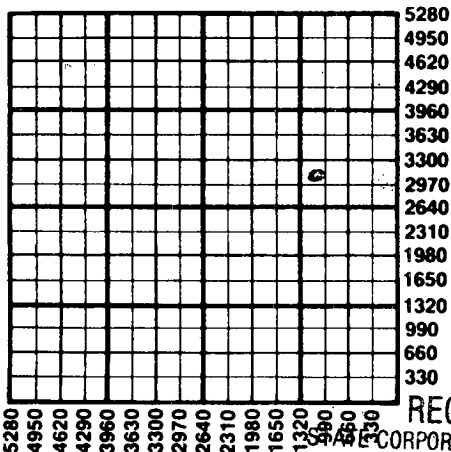

RECEIVED

SEP 4 - 1986

CONSERVATION DIVISION  
Wichita, Kansas

If an alternate 2 completion, cement in the production pipe from below any usable water to surface within 120 days of spud date.

State Corporation Commission of Kansas  
Conservation Division  
200 Colorado Derby Building  
Wichita, Kansas 67202  
(316) 263-3238