

CARD MUST BE TYPED

State of Kansas

CARD MUST BE SIGNED

## NOTICE OF INTENTION TO DRILL

(see rules on reverse side)

Expected Spud Date. 9 8 87  
month day year

OPERATOR: License # 4469  
Name KELT OIL & GAS INC.  
Address 900 COLLEGE AVE.  
City/State/Zip INDEPENDENCE, KS 67301  
Contact Person PETE JOHNSON  
Phone 316-331-0207

CONTRACTOR: License #  
Name UNKNOWN  
City/State

Well Drilled For:		Well Class:	Type Equipment:
<input checked="" type="checkbox"/> Oil	<input type="checkbox"/> Storage	<input checked="" type="checkbox"/> Infield	<input checked="" type="checkbox"/> Mud Rotary
<input type="checkbox"/> Gas	<input type="checkbox"/> Inj	<input type="checkbox"/> Pool Ext.	<input type="checkbox"/> Air Rotary
<input type="checkbox"/> OWWO	<input type="checkbox"/> Expl	<input type="checkbox"/> Wildcat	<input type="checkbox"/> Cable

If OWWO: old well info as follows:

Operator  
Well Name  
Comp Date Old Total Depth

I certify that well will comply with K.S.A. 55-101, et seq., plus eventually plugging hole to KCC specifications.

Date 9-2-87 Signature of Operator or Agent *Pete Johnson* Title Agent

For KCC Use:

Conductor Pipe Required feet; Minimum Surface Pipe Required 20 feet per Alt. X (2)  
This Authorization Expires 3-8-88 Effective 9-13-87 Approved By *P.H. 9-8-87*

API Number 15- 125-28,657-00-00  
NW NE NW Sec. 11 Twp. 34 S, Rg. 13E — East  
4785 — West  
3465 Ft. from South Line of Section  
Ft. from East Line of Section

(Note: Locate well on Section Plat on reverse side)


Nearest lease or unit boundary line 495 feet  
County MONTGOMERY  
Lease Name H. CARRA Well # KHHH 1  
Ground surface elevation feet MSL  
Domestic well within 330 feet: —yes ☒ no  
Municipal well within one mile: —yes ☒ no  
Depth to bottom of fresh water 175  
Depth to bottom of usable water  
Surface pipe by Alternate: 1 2 ☒  
Surface pipe planned to be set 20  
Conductor pipe required NA  
Projected Total Depth 900 feet  
Formation WEISER

Must be filed with the K.C.C. five (5) days prior to commencing well  
This card void if drilling not started within six (6) months of date received by K.C.C.

**Important procedures to follow:**

1. Notify District office before setting surface casing.
2. Set surface casing by circulating cement to the top.
3. File completion forms ACO-1 with K.C.C. within 120 days of well spud date, following instructions on ACO-1, side 1, and including copies of wireline logs.
4. Notify District office 48 hours prior to old well workover or re-entry.
5. Prior to filing Intent, prepare a proposed plugging plan in case well is D & A, then obtain approval of plan when calling district office prior to setting surface pipe.
6. Submit plugging report (CP-4) to K.C.C. after plugging is completed.
7. Obtain an approved injection docket number before disposing of salt water.
8. Notify K.C.C. within 10 days when injection commences or terminates.
9. If an alternate 2 completion, cement in the production pipe from below any usable water to surface within 120 days of spud date.

**A Regular Section of Land**  
**1 Mile = 5,280 Ft.**

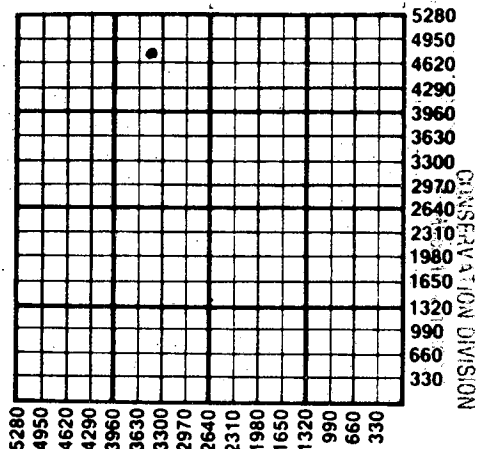

SEP 4 1987

STATE CORPORATION COMMISSION

State Corporation Commission of Kansas  
Conservation Division  
200 Colorado Derby Building  
Wichita, Kansas 67202-1212  
(316) 263-3238

9-4-87