

CARD MUST BE TYPED

State of Kansas
NOTICE OF INTENTION TO DRILL

CARD MUST BE SIGNED

(see rules on reverse side)

Starting Date: 3 24 85
month day year

API Number 15-099-22,302-00-00

OPERATOR: License # 7208

..... ~~SW~~ SW .. Sec .. 7. Twp .. 33 S, Rge .. 18 East
(location) West

Name Loraine Cleaver

Address Box 54

City/State/Zip Piqua, KS .. 66761

Contact Person Loraine Cleaver

Phone (316) 468-2510

..... 22.15... Ft North from Southeast Corner of Section

..... 51.15... Ft West from Southeast Corner of Section

(Note: Locate well on Section Plat on reverse side)

CONTRACTOR: License # 5687

Name Sun Drilling

City/State Box 54, Piqua, KS .. 66761

Nearest lease or unit boundary line 16.5 feet.

County Labette

Lease Name .. Virginia Wheeler. Well# ... 8

Domestic well within 330 feet : yes No

Municipal well within one mile : yes No

Well Drilled For: Well Class: Type Equipment:

Oil Swd

Infield

Mud Rotary

Gas Inj

Pool Ext.

Air Rotary

OWWO Expl

Wildcat

Cable

If OWWO: old well info as follows:

Operator

Well Name

Comp Date Old Total Depth

Projected Total Depth 650 feet

Projected Formation at TD Cattlemen

Expected Producing Formations

Depth to Bottom of fresh water 2.0 feet

Lowest usable water formation

Depth to Bottom of usable water 15.0 feet

Surface pipe by Alternate : 1 2

Surface pipe to be set 2.0 feet

Conductor pipe if any required

Ground surface elevation feet MSL

This Authorization Expires 9-20-85

Approved By D.W.P./H.C.C. 3-20-85

I certify that we will comply with K.S.A. 55-101, et seq., plus eventually plugging hole to K.C.C. specifications.

Date ... 3/20/85 ... Signature of Operator or Agent

Raqueel Robles

Title AS AGENT

Form C-1 4/84

m HC/KOHE 3-20-85


Must be filed with the K.C.C. five (5) days prior to commencing well
This card void if drilling not started within six (6) months of date received by K.C.C.

CONSERVATION DIVISION
Wichita, Kansas

MAR 20 1985

RECEIVED
STATE CORPORATION COMMISSION
1 Mile 5.280 Ft.
A Regular Section of Land

58-02-3

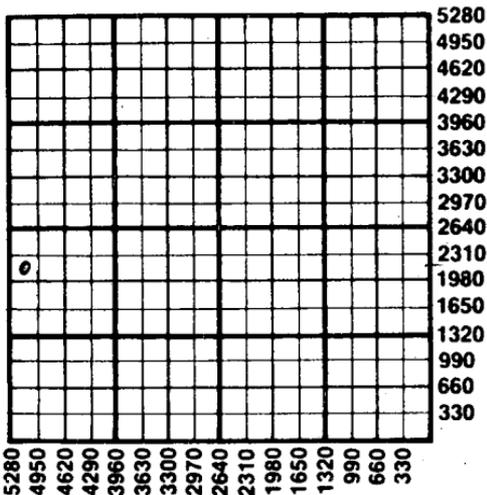

Important procedures to follow :

1. Notify District office before setting surface casing.
2. Set surface casing by circulating cement to the top.
3. File completion forms ACO-1 with K.C.C. within 90 days of well completion, following instructions on ACO-1, side 1, and including copies of wireline logs.
4. Notify District office 48 hours prior to old well workover or re-entry.
5. Prior to plugging, prepare a plugging plan, then obtain agreement from the appropriate district office for an approved plugging plan.
6. Submit plugging report (CP-4) to K.C.C. after plugging is completed.
7. Obtain an approved injection docket number before disposing of salt water.
8. Notify K.C.C. within 10 days when injection commences or terminates.
9. If an alternate 2 completion, cement in the production pipe from below any usable water to surface within 120 days of spud date.

State Corporation Commission of Kansas
Conservation Division
200 Colorado Derby Building
Wichita, Kansas 67202
(316) 263-3238