

CARD MUST BE TYPED

State of Kansas NOTICE OF INTENTION TO DRILL

(see rules on reverse side)

CARD MUST BE SIGNED

Starting Date: October 1, 1984
month day year

API Number 15- 099-22,165-00-00

OPERATOR: License # 9897

NW..SW..SE. Sec 9... Twp 33 S, Rge 19 East
(location) West

Name Alumni Oil Company

Address P.O. Box 5660, 1801 Broadway, Ste. 1201

City/State/Zip Denver, Colorado 80217

Contact Person Lee Mosse

Phone (303) 298-0722; (303) 751-9589

CONTRACTOR: License # 5379

Name Kephart Drilling Inc.

City/State RR. 1, Box 71, Thayer, KS. 66776

9.90 Ft North from Southeast Corner of Section
23.10 Ft West from Southeast Corner of Section
(Note: Locate well on Section Plat on reverse side)

Nearest lease or unit boundary line feet.

County Labette

Lease Name G. Carnahan Well# 9-34B

Domestic well within 330 feet: yes no

Municipal well within one mile: yes no

Well Drilled For: Well Class: Type Equipment:

- | | | | |
|---|-------------------------------|---|--|
| <input checked="" type="checkbox"/> Oil | <input type="checkbox"/> Swd | <input type="checkbox"/> Infield | <input type="checkbox"/> Mud Rotary |
| <input checked="" type="checkbox"/> Gas | <input type="checkbox"/> Inj | <input checked="" type="checkbox"/> Pool Ext. | <input checked="" type="checkbox"/> Air Rotary |
| <input type="checkbox"/> OWWO | <input type="checkbox"/> Expl | <input type="checkbox"/> Wildcat | <input type="checkbox"/> Cable |

If OWWO: old well info as follows:

Operator

Well Name

Comp Date Old Total Depth

Projected Total Depth 850 feet

Projected Formation at TD Mississippi Lime

Expected Producing Formations Mississippi Lime, Bartlesville

Depth to Bottom of fresh water None feet

Lowest usable water formation None feet

Depth to Bottom of usable water 150 feet

Surface pipe by Alternate: 1 2 20 feet

Surface pipe to be set None feet

Conductor pipe if any required None feet

Ground surface elevation feet MSL

This Authorization Expires 3-24-85

Approved By [Signature]

I certify that we will comply with K.S.A. 55-101, et seq., plus eventually plugging hole to K.C.C. specifications.

Date 9/20/84 Signature of Operator or Agent

[Signature]


Title General Manager

[Signature]
mhc/none 9/24/84

Must be filed with the K.C.C. five (5) days prior to commencing well
This card void if drilling not started within six (6) months of date received by K.C.C.

Important procedures to follow :

**A Regular Section of Land
1 Mile = 5,280 Ft.**

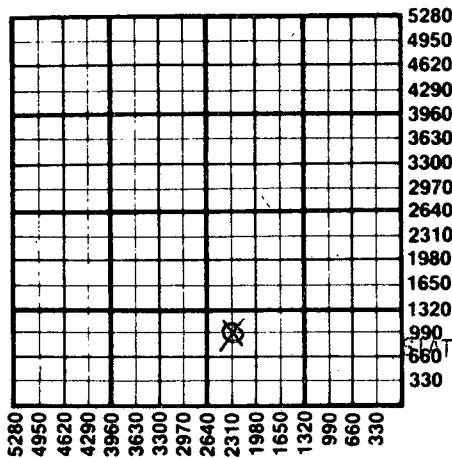

1. Notify District office before setting surface casing.
 2. Set surface casing by circulating cement to the top.
 3. File completion forms ACO-1 with K.C.C. within 90 days of well completion, following instructions on ACO-1, side 1, and including copies of wireline logs.
 4. Notify District office 48 hours prior to old well workover or re-entry.
 5. Prior to plugging, prepare a plugging plan, then obtain agreement from the appropriate district office for an approved plugging plan.
 6. Submit plugging report (CP-4) to K.C.C. after plugging is completed.
 7. Obtain an approved injection docket number before disposing of salt water.
8. Notify K.C.C. within 10 days when injection commences or terminates.
9. If an alternate 2 completion, cement in the production pipe from below any usable water to surface within 120 days of spud date.

RECEIVED

SEP 24 1981

CONSERVATION DIVISION
Wichita, Kansas

State Corporation Commission of Kansas
Conservation Division
200 Colorado Derby Building
Wichita, Kansas 67202
(316) 263-3238

9-24-81