

CARD MUST BE TYPED

State of Kansas
NOTICE OF INTENTION TO DRILL
 (see rules on reverse side)

CARD MUST BE SIGNED

Starting Date: 11 13 84
 month day year

OPERATOR: License # 9897
 Name Alumni Oil Co.
 Address P.O. Box 5660
 City/State/Zip Denver Co 80217
 Contact Person Lee Mossel
 Phone 303 298 0722

CONTRACTOR: License # 5379
 Name Kephart Drilling Inc.
 City/State R.R.1 Box 68A Thayer KS 66776

Well Drilled For:	Well Class:	Type Equipment:
<input checked="" type="checkbox"/> Oil <input type="checkbox"/> Swd <input type="checkbox"/> Infield <input type="checkbox"/> Mud Rotary		
<input checked="" type="checkbox"/> Gas <input type="checkbox"/> Inj <input type="checkbox"/> Pool Ext. <input checked="" type="checkbox"/> Air Rotary		
<input type="checkbox"/> OWWO <input type="checkbox"/> Expl <input checked="" type="checkbox"/> Wildcat <input type="checkbox"/> Cable		

If OWWO: old well info as follows:

Operator
 Well Name
 Comp Date Old Total Depth
 Projected Total Depth 875 feet
 Projected Formation at TD Mississippi
 Expected Producing Formations

I certify that we will comply with K.S.A. 55-101, et seq., plus eventually plugging hole to K.C.C. specifications.

Date 11/8/84 Signature of Operator or Agent *Raquel Robles* Title Asst. agent
Form C-1 4/84

API Number 15-099-22,215-00-00

SW. NW. SE. Sec. 9 ... Twp. 33. S, Rge. 19 ☒ East
 (location) ☐ West

... 1890 Ft North from Southeast Corner of Section
 ... 2310 Ft West from Southeast Corner of Section
 (Note: Locate well on Section Plat on reverse side)

Nearest lease or unit boundary line 330 feet.
 County Labette
 Lease Name J. Carnahan Well# 9-33B
 Domestic well within 330 feet : ☐ yes ☒ no
 Municipal well within one mile : ☐ yes ☒ no


Depth to Bottom of fresh water none feet
 Lowest usable water formation
 Depth to Bottom of usable water 150 feet
 Surface pipe by Alternate : 1 ☐ 2 ☒
 Surface pipe to be set 20 feet
 Conductor pipe if any required feet
 Ground surface elevation feet MSL.
 This Authorization Expires 5-8-85
 Approved By 11-8-84 *R*

11/14/84
11/18/84

CONSERVATION DIVISION
Wichita, Kansas

NOV 08 1984

NOIA Regular Section of Land
1 Mile 5.280 Ft

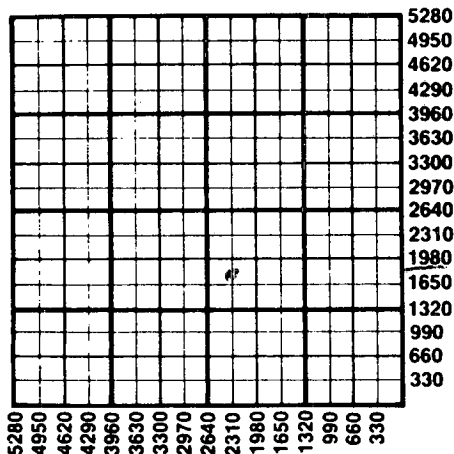

11-8-84

2

- 1. Notify District office before setting surface casing.**
- 2. Set surface casing by circulating cement to the top.**
- 3. File completion forms ACO-1 with K.C.C. within 90 days of well completion, following instructions on ACO-1, side 1, and including copies of wireline logs.**
- 4. Notify District office 48 hours prior to old well workover or re-entry.**
- 5. Prior to plugging, prepare a plugging plan, then obtain agreement from the appropriate district office for an approved plugging plan.**
- 6. Submit plugging report (CP-4) to K.C.C. after plugging is completed.**
- 7. Obtain an approved injection docket number before disposing of salt water.**
- 8. Notify K.C.C. within 10 days when injection commences or terminates.**
- 9. If an alternate 2 completion, cement in the production pipe from below any usable water to surface within 120 days of spud date.**

**State Corporation Commission of Kansas
Conservation Division
200 Colorado Derby Building
Wichita, Kansas 67202
(316) 263-3238**