

CARD MUST BE TYPED

State of Kansas
NOTICE OF INTENTION TO DRILL
(see rules on reverse side)

CARD MUST BE SIGNED

Starting Date: October 1, 1984
month day year

API Number 15- 099-22,170-00-00

OPERATOR: License # 9897
Name Alumni Oil Company
Address P.O. Box 5660, 1801 Broadway, Ste. 1201
City/State/Zip Denver, Colorado 80217
Contact Person Lee Mossel
Phone (303) 298-0722; (303) 751-9589

SE NE SW Sec. 10 Twp. 33 S, Rge. 19 East
(location) West
.....1650... Ft North from Southeast Corner of Section
.....2970... Ft West from Southeast Corner of Section
(Note: Locate well on Section Plat on reverse side)

CONTRACTOR: License # 5379
Name Kephart Drilling Inc.
City/State RR. 1, Box 71, Thayer, KS. 66776

Nearest lease or unit boundary line 330 feet.
County Lafayette
Lease Name E. Carnahan Well# 10-23A
Domestic well within 330 feet: yes no
Municipal well within one mile: yes no

Well Drilled For: Well Class: Type Equipment:
 Oil Swd Infield Mud Rotary
 Gas Inj Pool Ext. Air Rotary
 OWWO Expl Wildcat Cable

Depth to Bottom of fresh water None feet
Lowest usable water formation None feet
Depth to Bottom of usable water 150 feet
Surface pipe by Alternate: 1 20
Surface pipe to be set None feet
Conductor pipe if any required None feet
Ground surface elevation None feet MSL

If OWWO: old well info as follows:
Operator
Well Name
Comp Date 850 Old Total Depth
Projected Total Depth 850 feet
Projected Formation at TD Mississippi Lime
Expected Producing Formations Mississippi Lime, Bartlesville

This Authorization Expires 3-24-85
Approved By [Signature]

I certify that we will comply with K.S.A. 55-101, et seq., plus eventually plugging hole to K.C.C. specifications.


Date 9/20/84 Signature of Operator or Agent [Signature] Title General Manager

MHC/UDHE 9/24/84 Form C-1 4/84

Must be filed with the K.C.C. five (5) days prior to commencing well
This card void if drilling not started within six (6) months of date received by K.C.C.

Important procedures to follow :

A Regular Section of Land
1 Mile = 5,280 Ft.

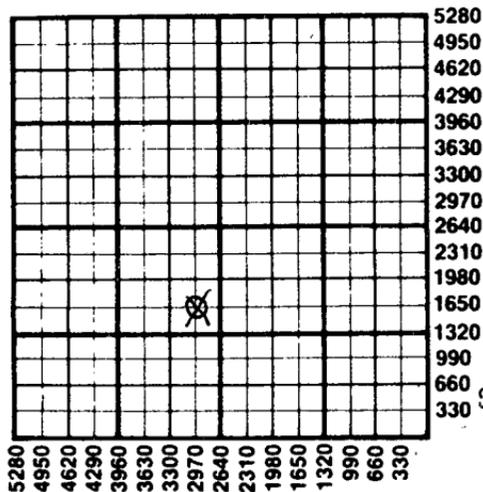

1. Notify District office before setting surface casing.
 2. Set surface casing by circulating cement to the top.
 3. File completion forms ACO-1 with K.C.C. within 90 days of well completion, following instructions on ACO-1, side 1, and including copies of wireline logs.
 4. Notify District office 48 hours prior to old well workover or re-entry.
 5. Prior to plugging, prepare a plugging plan, then obtain agreement from the appropriate district office for an approved plugging plan.
 6. Submit plugging report (CP-4) to K.C.C. after plugging is completed.
 7. Obtain an approved injection docket number before disposing of salt water.
 8. Notify K.C.C. within 10 days when injection commences or terminates.
9. After completion, cement in the production pipe from below any usable water to surface within 120 days of spud date.

RECEIVED
STATE CORPORATION COMMISSION

SEP 24 1984

CONSERVATION DIVISION
Wichita, Kansas

9-24-84

State Corporation Commission of Kansas
Conservation Division
200 Colorado Derby Building
Wichita, Kansas 67202
(316) 263-3238