

CARD MUST BE TYPED

NOTICE OF INTENTION TO DRILL

State of Kansas
(see rules on reverse side)

CARD MUST BE SIGNED

Starting Date: October 1, 1984

API Number 15- 099-22,171-00-00

month day year
9897

SE. SE. SW Sec 10. Twp 33 S, Rge 19 East
(location) West

OPERATOR: License # Alumni Oil Company

Name P.O. Box 5660, 1801 Broadway, Ste. 1201

Address Denver, Colorado 80217 330... Ft North from Southeast Corner of Section

City/State/Zip Lee Mosset 29.70... Ft West from Southeast Corner of Section

Contact Person (303) 298-0722; (303) 751-9589 (Note: Locate well on Section Plat on reverse side)

Phone 5379 Nearest lease or unit boundary line 330..... feet.

CONTRACTOR: License # Kephart D.L.G. Inc

Name RR 1, Box 71, Thayer, KS 66776 County Labette

City/State Lease Name E. Carnahan Well# 10-24A

Well Drilled For: Well Class: Type Equipment:

- Oil Swd Infield Mud Rotary
- Gas Inj Pool Ext. Air Rotary
- OWWO Expl Wildcat Cable

Domestic well within 330 feet: yes no
Municipal well within one mile: yes no

If OWWO: old well info as follows:

Operator

Well Name

Comp Date 850 Old Total Depth

Projected Total Depth Mississippi Lime

Projected Formation at TD Mississippi Lime, Bartlesville

Expected Producing Formations

Depth to Bottom of fresh water None

Lowest usable water formation None

Depth to Bottom of usable water 150

Surface pipe by Alternate: 1 2

Surface pipe to be set 20

Conductor pipe if any required None

Ground surface elevation feet MSL

This Authorization Expires 3-24-85

Approved By 9-24-84 [Signature]

I certify that we will comply with K.S.A. 55-101, et seq., plus eventually plugging hole to K.C.C. specifications.

Date 9/20/84 Signature of Operator or Agent


[Signature] Title General Manager

MHC/KOITE 9/24/84

**Must be filed with the K.C.C. five (5) days prior to commencing well
This card void if drilling not started within six (6) months of date received by K.C.C.**

Important procedures to follow :

**A Regular Section of Land
1 Mile = 5,280 Ft.**

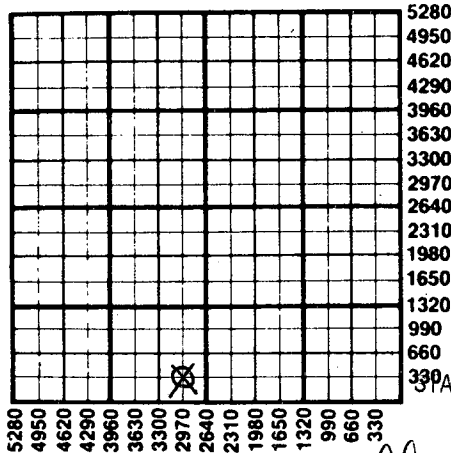

1. Notify District office before setting surface casing.
2. Set surface casing by circulating cement to the top.
3. File completion forms ACO-1 with K.C.C. within 90 days of well completion, following instructions on ACO-1, side 1, and including copies of wireline logs.
4. Notify District office 48 hours prior to old well workover or re-entry.
5. Prior to plugging, prepare a plugging plan, then obtain agreement from the appropriate district office for an approved plugging plan.
6. Submit plugging report (CP-4) to K.C.C. after plugging is completed.
7. Obtain an approved injection docket number before disposing of salt water.
8. Notify K.C.C. within 10 days when injection commences or terminates.

RECEIVED

State Corporation Commission
If an alternate 2 completion, cement in the production pipe from below any producible water to surface within 120 days of spud date.

9-24-88

CONSERVATION DIVISION
Wichita, Kansas

SFP 2.4 1984

**State Corporation Commission of Kansas
Conservation Division
200 Colorado Derby Building
Wichita, Kansas 67202
(316) 263-3238**