

CARD MUST BE TYPED

State of Kansas
NOTICE OF INTENTION TO DRILL
(see rules on reverse side)

CARD MUST BE SIGNED

Starting Date:October 21.....1984.....
month day year

API Number 15- 099-22,192-00-00

OPERATOR: License # ..9897.....

SE SW NW 20 East
..... (location) Sec Twp 33 S, Rge 19 West

Name Alumni Oil Company.....

Address P.O. Box 5660, 1801 Broadway, Ste. 1201.....

City/State/Zip Denver, Colorado 80217.....

Contact Person Lee Mosset.....

Phone (303) 298-0722; (303) 751-9589.....

CONTRACTOR: License # 5379.....

2970... Ft North from Southeast Corner of Section
4290... Ft West from Southeast Corner of Section
(Note: Locate well on Section Plat on reverse side)

Name Kephart Drilling Inc.....

City/State R.R. 1, Box 68A, Thayer, KS 66776.....

Well Drilled For: R.R. 1, Box 68A, Thayer, KS 66776

Nearest lease or unit boundary line 330..... feet.
County Labette
Lease Name Ware Well # 20-12A

- Oil Swd Infield Mud Rotary
- Gas Inj Pool Ext. Air Rotary
- OWWO Expl Wildcat Cable

- Domestic well within 330 feet : yes no
- Municipal well within one mile : yes no

If OWWO: old well info as follows:

Operator
Well Name
Comp Date Old Total Depth

Projected Total Depth 850..... feet

Projected Formation at TD Mississippi Lime.....

Expected Producing Formations Mississippi Lime; Bartlesville.....

Depth to Bottom of fresh water None..... feet
Lowest usable water formation None.....
Depth to Bottom of usable water 150 / 100..... feet
Surface pipe by Alternate : I 2
Surface pipe to be set 20..... feet
Conductor pipe if any required None..... feet
Ground surface elevation
This Authorization Expires 4-9-85.....

I certify that we will comply with K.S.A. 55-101, et seq., plus eventually plugging hole to K.C.C. specifications.

Date 10/3/84 Signature of Operator or Agent

Lee Mosset


Approved By 10-9-84 *L*.....

Title General Manager.....

Must be filed with the K.C.C. five (5) days prior to commencing well
This card void if drilling not started within six (6) months of date received by K.C.C.

Important procedures to follow :

A Regular Section of Land
1 Mile = 5,280 Ft.

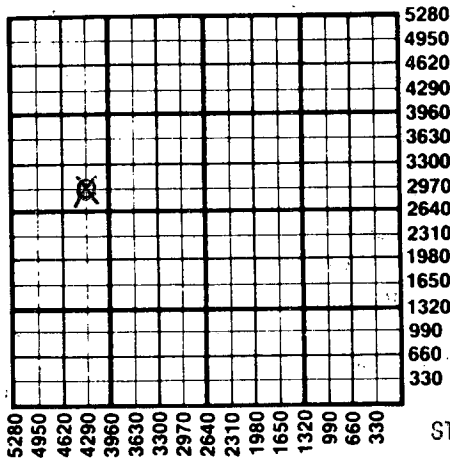

1. Notify District office before setting surface casing.
2. Set surface casing by circulating cement to the top.
3. File completion forms ACO-1 with K.C.C. within 90 days of well completion, following instructions on ACO-1, side 1, and including copies of wireline logs.
4. Notify District office 48 hours prior to old well workover or re-entry.
5. Prior to plugging, prepare a plugging plan, then obtain agreement from the appropriate district office for an approved plugging plan.
6. Submit plugging report (CP-4) to K.C.C. after plugging is completed.
7. Obtain an approved injection docket number before disposing of salt water.
8. Notify K.C.C. within 10 days when injection commences or terminates.
9. If an alternate 2 completion, cement in the production pipe from below any usable water to surface within 120 days of spud date.

RECEIVED

STATE CORPORATION COMMISSION

State Corporation Commission of Kansas

Conservation Division

200 Colorado Derby Building

Wichita, Kansas 67202

(316) 263-3238

CONSERVATION DIVISION

Wichita, Kansas

OCT 9 1984

10-9-84