

NOTICE OF INTENTION TO DRILL

(see rules on reverse side)

Starting Date May 8 1986 month day year

API Number 15-099-22,470-00-00

OPERATOR: License # 7208 Name Loraine Cleaver Address Box 54 City/State/Zip Piqua, Kansas 66761 Contact Person Loraine Cleaver Phone 316 468 2050

SE SE SW Sec. 29 Twp. 33 S, Rg. 18 330 Ft. from South Line of Section 2970 Ft. from East Line of Section

(Note: Locate well on Section Plat on reverse side)

CONTRACTOR: License # 5379 Name Kephart Drilling, Inc. City/State R. 1, Box 68A, Thayer, KS 66776

Nearest lease or unit boundary line 330 feet County Labette Lease Name Ralph E. Bussman & James O. Bussman Well # 1 Ground surface elevation feet MSL

Well Drilled For: Well Class: Type Equipment: Oil SWD Infield Mud Rotary Gas Inj Pool Ext Air Rotary OWWO Expl Wildcat Cable

Domestic well within 330 feet: yes no Municipal well within one mile: yes no Depth to bottom of fresh water 20 Depth to bottom of usable water 150 Surface pipe by Alternate: 1 2 Surface pipe planned to be set 20 Conductor pipe required Projected Total Depth 400 feet Formation

If OWWO: old well info as follows:

Operator Well Name Comp Date Old Total Depth

I certify that well will comply with K.S.A. 55-101, et seq., plus eventually plugging hole to KCC specifications.

Date 5/8/86 Signature of Operator or Agent Title as agent

For KCC Use:

Conductor Pipe Required feet; Minimum Surface Pipe Required feet per Alt. This Authorization Expires 11-8-86 Approved By PCH 5-8-86

PCH/KCH

Must be filed with the K.C.C. five (5) days prior to commencing well  
This card void if drilling not started within six (6) months of date received by K.C.C.

RECEIVED  
STATE CORPORATION COMMISSION


Important procedures to follow:

MAY 8 1986

A Regular Section of Land

1 Mile = 5,280 Ft.

CONSERVATION DIVISION  
Wichita, Kansas

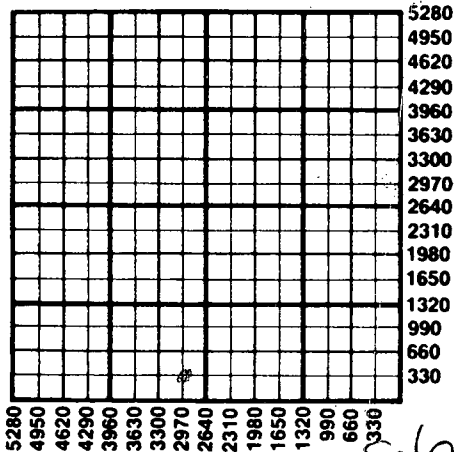

1. Notify District office before setting surface casing.
2. Set surface casing by circulating cement to the top.
3. File completion forms ACO-1 with K.C.C. within 90 days of well completion, following instructions on ACO-1, side 1, and including copies of wireline logs.
4. Notify District office 48 hours prior to old well workover or re-entry.
5. Prior to filing Intent, prepare a proposed plugging plan in case well is D & A, then obtain approval of plan when calling district office prior to setting surface pipe.
6. Submit plugging report (CP-4) to K.C.C. after plugging is completed.
7. Obtain an approved injection docket number before disposing of salt water.
8. Notify K.C.C. within 10 days when injection commences or terminates.
9. If an alternate 2 completion, cement in the production pipe from below any usable water to surface within 120 days of spud date.

State Corporation Commission of Kansas  
Conservation Division  
200 Colorado Derby Building  
Wichita, Kansas 67202  
(316) 263-3238