

CARD MUST BE TYPED

State of Kansas
NOTICE OF INTENTION TO DRILL

CARD MUST BE SIGNED

(see rules on reverse side)

Starting Date: August 27 1984
month day year

API Number 15- 099-22,120-00-00
X
XX East
West

OPERATOR: License # 5516
Name Central Plains Energy Exploration Inc.
Address P.O. Box 433
City/State/Zip Cherryvale, Kansas, 67335
Contact Person Bill Bumgarner
Phone 316.336.2148

NE 1/4 (location) NW/4 SW/4 Sec 31 Twp 33 S, Rge 18
1980 Ft North from Southeast Corner of Section
4950 Ft West from Southeast Corner of Section
(Note: Locate well on Section Plat on reverse side)

CONTRACTOR: License # 9784
Name Twin Rivers Drilling
City/State Independence, Kansas

Nearest lease or unit boundary line 330 feet.
County Labette
Lease Name Carlson Well# 1
Domestic well within 330 feet: yes no
Municipal well within one mile: yes no

Well Drilled For: Well Class: Type Equipment:
 Oil Swd Infield Mud Rotary
 Gas Inj Pool Ext. Air Rotary
 OWWO Expl Wildcat Cable

Depth to Bottom of fresh water 40 feet
Lowest usable water formation 40
Depth to Bottom of usable water 150 40 feet
Surface pipe by Alternate: 1 2
Surface pipe to be set 40 feet
Conductor pipe if any required feet
Ground surface elevation N/A feet MSL
This Authorization Expires 2-22-85
Approved By 8-22-84 R

If OWWO: old well info as follows:

Operator
Well Name
Comp Date Old Total Depth

Projected Total Depth 1000 feet
Projected Formation at TD Mississippi
Expected Producing Formations Mississippi

I certify that we will comply with K.S.A. 55-101, et seq., plus eventually plugging hole to K.C.C. specifications.

Date 8/21/84 Signature of Operator or Agent Bill Bumgarner Title Agent
m HC/KOHE 8/22/84


Must be filed with the K.C.C. five (5) days prior to commencing well
This card void if drilling not started within six (6) months of date received by K.C.C.

8-22-84

Important procedures to follow:

1. Notify District office before setting surface casing.
2. Set surface casing by circulating cement to the top.
3. File completion forms ACO-1 with K.C.C. within 90 days of well completion, following instructions on ACO-1, side 1, and including copies of wireline logs.
4. Notify District office 48 hours prior to old well workover or re-entry.
5. Prior to plugging, prepare a plugging plan, then obtain agreement from the appropriate district office for an approved plugging plan.
6. Submit plugging report (CP-4) to K.C.C. after plugging is completed.
7. Obtain an approved injection docket number before disposing of salt water.
8. Notify K.C.C. within 10 days when injection commences or terminates.
9. If an alternate 2 completion, cement in the production pipe from below any usable water to surface within 120 days of spud date.

A Regular Section of Land
1 Mile = 5,280 Ft.

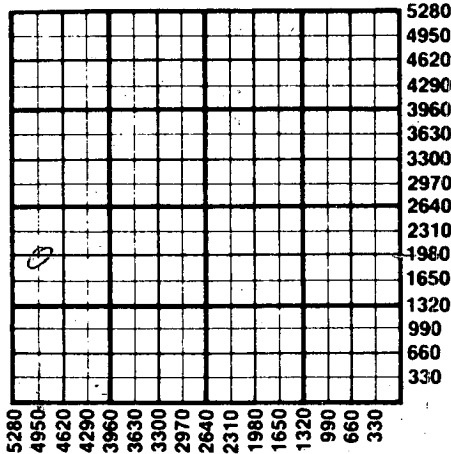

RECEIVED
STATE CORPORATION COMMISSION

AUG 22 1984

CONSERVATION DIVISION
Wichita, Kansas

State Corporation Commission of Kansas
Conservation Division
200 Colorado Derby Building
Wichita, Kansas 67202
(316) 263-3238