

CARD MUST BE TYPED

State of Kansas
NOTICE OF INTENTION TO DRILL
 (see rules on reverse side)

CARD MUST BE SIGNED

Starting Date: 1-10-85
 month day year

OPERATOR: License # 5516
 Name Central Plains Energy Exploration
 Address P. O. Box 433
 City/State/Zip Cherryvale, KS 67335
 Contact Person Bill Bumgarner
 Phone (316) 336-2148

CONTRACTOR: License # 9605
 Name Rusty's Drilling
 City/State Chanute, KS 66720

Well Drilled For:	Well Class:	Type Equipment:
☒ Oil ☐ Swd	☒ Infield	☐ Mud Rotary
☒ Gas ☐ Inj	☐ Pool Ext.	☒ Air Rotary
☐ OWWO ☐ Expl	☐ Wildcat	☐ Cable

If OWWO: old well info as follows:

Operator

Well Name

Comp Date Old Total Depth

Projected Total Depth 900 feet

Projected Formation at TD Mississippi

Expected Producing Formations Mississippi

I certify that we will comply with K.S.A. 55-101, et seq., plus eventually plugging hole to K.C.C. specifications.

Date Jan. 2, 1985 Signature of Operator or Agent [Signature]

API Number 15- 099-22,255-00

C. SW, NW, SW Sec 31 Twp 33 S, Rge 18 ☒ East ☐ West
 (location)

1650 Ft North from Southeast Corner of Section
4950 Ft West from Southeast Corner of Section
 (Note: Locate well on Section Plat on reverse side)

Nearest lease or unit boundary line 330 feet.
 County Labette
 Lease Name Carlson Well# 3
 Domestic well within 330 feet: ☐ yes ☒ no
 Municipal well within one mile: ☐ yes ☒ no

Depth to Bottom of fresh water 40 feet
 Lowest usable water formation 100 feet
 Depth to Bottom of usable water 100-150 feet
 Surface pipe by Alternate: 1 ☐ 2 ☒
 Surface pipe to be set 20 feet
 Conductor pipe if any required None feet
 Ground surface elevation Unknown feet MSL
 This Authorization Expires 7-4-85
 Approved By 1-4-85 [Signature]


Title Secretary.....

Form C-1 4/84

MHC/UDHE 1-4-85

Must be filed with the K.C.C. five (5) days prior to commencing well
This card void if drilling not started within six (6) months of date received by K.C.C.

A Regular Section of Land
1 Mile = 5,280 Ft.

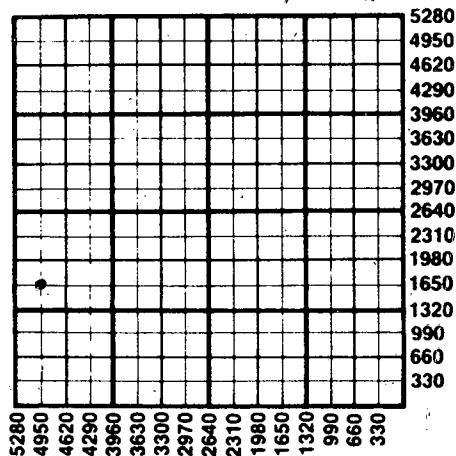

Important procedures to follow:

1. Notify District office before setting surface casing.
2. Set surface casing by circulating cement to the top.
3. File completion forms ACO-1 with K.C.C. within 90 days of well completion, following instructions on ACO-1, side 1, and including copies of wireline logs.
4. Notify District office 48 hours prior to old well workover or re-entry.
5. Prior to plugging, prepare a plugging plan, then obtain agreement from the appropriate district office for an approved plugging plan.
6. Submit plugging report (CP-4) to K.C.C. after plugging is completed.
7. Obtain an approved injection docket number before disposing of salt water.
8. Notify K.C.C. within 10 days when injection commences or terminates.
9. If an alternate 2 completion, cement in the production pipe from below any usable water to surface within 120 days of spud date.

RECEIVED
STATE CORPORATION COMMISSION
1-4-85
JAN 04 1985
CONSERVATION DIVISION
Wichita, Kansas

State Corporation Commission of Kansas
Conservation Division
200 Colorado Derby Building
Wichita, Kansas 67202
(316) 263-3238