

CARD MUST BE TYPED

State of Kansas
NOTICE OF INTENTION TO DRILL

CARD MUST BE SIGNED

(see rules on reverse side)

Starting Date: 2-9-85
month day year

API Number 15- 099-22,270-00-00

OPERATOR: License # 5516

NE NE SW NW East
NE NE SW NW Sec 31 Twp 33 S, Rge 18 West
(location)

Name ..Central Plains Energy Exploration..

Address P.O. Box 433

City/State/Zip ..Cherryvale, KS. 67335

Contact Person ..Bill Bungarner

Phone ..(316) 336-2148

3900 Ft North from Southeast Corner of Section
4000 Ft West from Southeast Corner of Section
(Note: Locate well on Section Plat on reverse side)

CONTRACTOR: License # 9960

Nearest lease or unit boundary line 1280 feet.

County ..Labette

Name ..Tinnin Bros, Drilling

Lease Name ..A-M-E Church Well# 7

City/State ..Nowata, Oklahoma

Domestic well within 330 feet: yes no

Well Drilled For: Well Class: Type Equipment:

- Oil Swd Infield Mud Rotary
- Gas Inj Pool Ext. Air Rotary
- OWWO Expl Wildcat Cable

Municipal well within one mile: yes no

If OWWO: old well info as follows:

Depth to Bottom of fresh water 40 feet

Lowest usable water formation 0

Depth to Bottom of usable water 150 feet

Surface pipe by Alternate: 1 2

Surface pipe to be set 20 feet

Conductor pipe if any required None feet

Ground surface elevation N/A feet MSL

This Authorization Expires 8-5-85

Approved By 2-5-85 [Signature]

I certify that we will comply with K.S.A. 55-101, et seq., plus eventually plugging hole to K.C.C. specifications.

Date 2-4-85 Signature of Operator or Agent [Signature]

Secretary [Signature]

MHC/UDHE 2-5-85

Must be filed with the K.C.C. five (5) days prior to commencing well
 This card void if drilling not started within six (6) months of date received by K.C.C.


RECEIVED
 STATE CORPORATION COMMISSION

FEB 05 1985

Important procedures to follow:

CONSERVATION DIVISION
 WICHITA, KANSAS

A Regular Section of Land
1 Mile = 5,280 Ft.

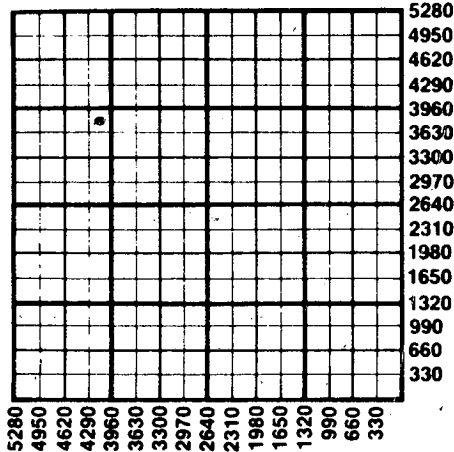

1. Notify District office before setting surface casing, Wichita, Kansas.
2. Set surface casing by circulating cement to the top.
3. File completion forms ACO-1 with K.C.C. within 90 days of well completion, following instructions on ACO-1, side 1, and including copies of wireline logs.
4. Notify District office 48 hours prior to old well workover or re-entry.
5. Prior to plugging, prepare a plugging plan, then obtain agreement from the appropriate district office for an approved plugging plan.
6. Submit plugging report (CP-4) to K.C.C. after plugging is completed.
7. Obtain an approved injection docket number before disposing of salt water.
8. Notify K.C.C. within 10 days when injection commences or terminates.
9. If an alternate 2 completion, cement in the production pipe from below any usable water to surface within 120 days of spud date.

State Corporation Commission of Kansas
Conservation Division
200 Colorado Derby Building
Wichita, Kansas 67202
(316) 263-3238