

CARD MUST BE TYPED

State of Kansas
NOTICE OF INTENTION TO DRILL
(see rules on reverse side)

CORRECTION
2-28-85
CARD MUST BE SIGNED

Starting Date: 2 28 85
month day year

API Number 15- 003-22,571 Correction

OPERATOR: License # 9558
Name Simca Oil, Inc.
Address 5401 College Blvd., Suite 10
City/State/Zip Leawood, KS 66211
Contact Person Rick Andrews
Phone (913) 341-8459

..... SE 1/4 Sec 19 .. Twp . 22 S, Rge ... 20 East
(Location) West

CONTRACTOR: License # 5678
Name Harold L. Brady
City/State Paola, KS 66071

* 1320 Ft North from Southeast Corner of Section
* 660 Ft West from Southeast Corner of Section
(Note: Locate well on Section Plat on reverse side)

Well Drilled For: Well Class: Type Equipment:
 Oil Swd Infield Mud Rotary
 Gas Inj Pool Ext. Air Rotary
 OWWO Expl Wildcat Cable

Nearest lease or unit boundary line 660 feet.
County Anderson
Lease Name Church Well# 2

If OWWO: old well info as follows:
Operator
Well Name
Comp Date Old Total Depth
Projected Total Depth 1200 feet
Projected Formation at TD Mississippian
Expected Producing Formations

Domestic well within 330 feet : yes no
Municipal well within one mile : yes no
Depth to Bottom of fresh water 75 feet
Lowest usable water formation
Depth to Bottom of usable water 150 feet
Surface pipe by Alternate : 1 2 X
Surface pipe to be set 20 feet
Conductor pipe if any required feet
Ground surface elevation feet MSL.
This Authorization Expires 8-4-85
Approved By 2-4-85

I certify that we will comply with K.S.A. 55-101, et seq., plus eventually plugging hole to K.C.C. specifications. *x was 1485 FEL*

Date 2/28/85 Signature of Operator or Agent *Raquel A. Gobles* Title As Agent
165 FEL


Must be filed with the K.C.C. five (5) days prior to commencing well
This card void if drilling not started within six (6) months of date received by K.C.C.

Wichita, Kansas
 CONSERVATION DIVISION

58-20
 FEB 28 1985
 STATE CONSERVATION COMMISSION
 A Regular Section of Land
 1 Mile x 3 1/2 Miles

Important procedures to follow :

1. Notify District office before setting surface casing.
2. Set surface casing by circulating cement to the top.
3. File completion forms ACO-1 with K.C.C. within 90 days of well completion, following instructions on ACO-1, side 1, and including copies of wireline logs.
4. Notify District office 48 hours prior to old well workover or re-entry.
5. Prior to plugging, prepare a plugging plan, then obtain agreement from the appropriate district office for an approved plugging plan.
6. Submit plugging report (CP-4) to K.C.C. after plugging is completed.
7. Obtain an approved injection docket number before disposing of salt water.
8. Notify K.C.C. within 10 days when injection commences or terminates.
9. If an alternate 2 completion, cement in the production pipe from below any usable water to surface within 120 days of spud date.

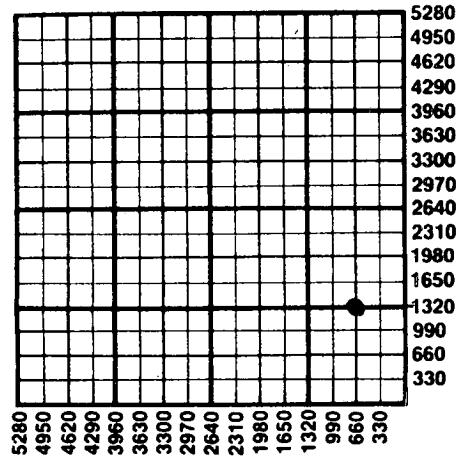

State Corporation Commission of Kansas
Conservation Division
200 Colorado Derby Building
Wichita, Kansas 67202
(316) 263-3238