

CARD MUST BE TYPED

NOTICE OF INTENTION TO DRILL

State of Kansas
(see rules on reverse side)

2nc CORRECTION
CARD-MUST BE SIGNED

Starting Date: 7 12 1985
month day year

API Number 15- 003-22,577 ^{00-00 2-15-85} CORRECTION

OPERATOR: License # 9558
Name Simca Oil, Inc.
Address 10720 Horton
City/State/Zip Overland Park, KS 66211
Contact Person Rick Andrews
Phone 913 341 8459

App. ^{10/2} SE SE Sec. 19. Twp. 22 S, Rge. 20 East West
(location)

¹³²⁰ Ft North from Southeast Corner of Section
⁹⁹⁰ Ft West from Southeast Corner of Section
(Note: Locate well on Section Plat on reverse side)

CONTRACTOR: License # 5678
Name Harold L. Brady
City/State Paola, Ks 66071

Nearest lease or unit boundary line 825 feet.
County Anderson

* Lease Name Church Well# .3-R.....

| Well Drilled For: | Well Class: | Type Equipment: |
|---|---|--|
| <input checked="" type="checkbox"/> Oil <input type="checkbox"/> Swd <input type="checkbox"/> Infield | <input checked="" type="checkbox"/> Infield | <input checked="" type="checkbox"/> Mud Rotary |
| <input type="checkbox"/> Gas <input type="checkbox"/> Inj <input type="checkbox"/> Pool Ext. | <input type="checkbox"/> Pool Ext. | <input type="checkbox"/> Air Rotary |
| <input type="checkbox"/> OWWO <input type="checkbox"/> Expl <input type="checkbox"/> Wildcat | <input type="checkbox"/> Wildcat | <input type="checkbox"/> Cable |

Domestic well within 330 feet: yes no
Municipal well within one mile: yes no

If OWWO: old well info as follows:

Operator
Well Name
Comp Date Old Total Depth
Projected Total Depth 1200 feet
Projected Formation at TD Mississippian
Expected Producing Formations

Depth to Bottom of fresh water 7.5 feet
Lowest usable water formation
Depth to Bottom of usable water 150 feet
Surface pipe by Alternate: 1 2
Surface pipe to be set 20 feet
Conductor pipe if any required feet
Ground surface elevation feet MSL
This Authorization Expires 8-18-85
Approved By ²⁻¹⁸⁻⁸⁵ kwqs #5

I certify that we will comply with K.S.A. 55-101, et seq., plus eventually plugging hole to K.C.C. specifications.


Date 7/12/85 Signature of Operator or Agent

Clairie Pasham Title as agent

Must be filed with the K.C.C. five (5) days prior to commencing well
This card void if drilling not started within six (6) months of date received by K.C.C.

Important procedures to follow :

A Regular Section of Land
1 Mile = 5,280 Ft.

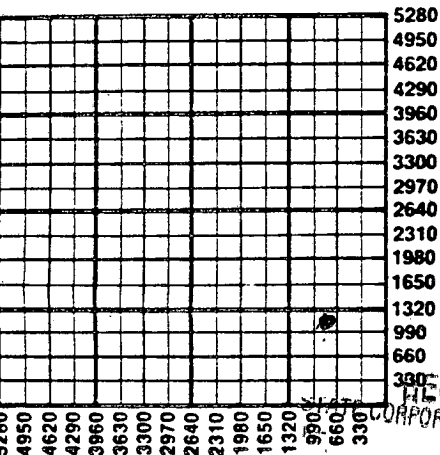

1. Notify District office before setting surface casing.
2. Set surface casing by circulating cement to the top.
3. File completion forms ACO-1 with K.C.C. within 90 days of well completion, following instructions on ACO-1, side 1, and including copies of wireline logs.
4. Notify District office 48 hours prior to old well workover or re-entry.
5. Prior to plugging, prepare a plugging plan, then obtain agreement from the appropriate district office for an approved plugging plan.
6. Submit plugging report (CP-4) to K.C.C. after plugging is completed.
7. Obtain an approved injection docket number before disposing of salt water.
8. Notify K.C.C. within 10 days when injection commences or terminates.
9. If an alternate 2 completion, cement in the production pipe from below any usable water to surface within 120 days of spud date.

RECEIVED
CORPORATION COMMISSION
JUL 12 1985
07-12-85
CONSERVATION DIVISION
Wichita, Kansas

State Corporation Commission of Kansas
Conservation Division
200 Colorado Derby Building
Wichita, Kansas 67202
(316) 263-3238