

CARD MUST BE TYPED

NOTICE OF INTENTION TO DRILL

CARD MUST BE SIGNED

State of Kansas
(see rules on reverse side)

Starting Date: 5 - 31 - 85
month day year

API Number 15- 037-21, 334-00-00

OPERATOR: License # 4358
Name Stanley Boyer
Address 309 S. Osage Apt. -3
City/State/Zip Girard, Kansas 66743
Contact Person Stanley Boyer
Phone 316-724-8661

Far East East
Sec 13 Twp 28 S, Rge 23 West
(location)

CONTRACTOR: License # 5419
Name J-J Drilling Co., inc.
City/State Erie, Kansas 66733

4760 Ft North from Southeast Corner of Section
4760 Ft West from Southeast Corner of Section
(Note: Locate well on Section Plat on reverse side)

Well Drilled For: Well Class: Type Equipment:
 Oil Swd Infield Mud Rotary
 Gas Inj Pool Ext. Air Rotary
 OWWO Expl Wildcat Cable

Nearest lease or unit boundary line 165 feet.
County Crawford
Lease Name Boyer Well# 1

Domestic well within 330 feet: yes no
Municipal well within one mile: yes no

If OWWO: old well info as follows:
Operator
Well Name
Comp Date Old Total Depth

Depth to Bottom of fresh water 20 feet
Lowest usable water formation unknown
Depth to Bottom of usable water 100 feet
Surface pipe by Alternate: 1 2
Surface pipe to be set 20 feet
Conductor pipe if any required None feet

Projected Total Depth 625 feet
Projected Formation at TD Mississippi Lime
Expected Producing Formations Cherakee, Bartlesville, & Miss

Ground surface elevation unknown feet MSI.
This Authorization Expires 11-24-85
Approved By 5-24-85

I certify that we will comply with K.S.A. 55-101, et seq., plus eventually plugging hole to K.C.C. specifications.

Date Signature of Operator or Agent Stanley Boyer Title Operator and Agent

MHC/KOHE 5-24-85

Must be filed with the K.C.C. five (5) days prior to commencing well
 This card void if drilling not started within six (6) months of date received by K.C.C.

RECEIVED
 STATE CORPORATION COMMISSION

5-24-85


Important procedures to follow:

MAY 24 1985

CONSERVATION DIVISION
 Wichita, Kansas

**A Regular Section of Land
 1 Mile = 5,280 Ft.**

1. Notify District office before setting surface casing.
2. Set surface casing by circulating cement to the top.
3. File completion forms ACO-1 with K.C.C. within 90 days of well completion, following instructions on ACO-1, side I, and including copies of wireline logs.
4. Notify District office 48 hours prior to old well workover or re-entry.
5. Prior to plugging, prepare a plugging plan, then obtain agreement from the appropriate district office for an approved plugging plan.
6. Submit plugging report (CP-4) to K.C.C. after plugging is completed.
7. Obtain an approved injection docket number before disposing of salt water.
8. Notify K.C.C. within 10 days when injection commences or terminates.
9. If an alternate 2 completion, cement in the production pipe from below any usable water to surface within 120 days of spud date.

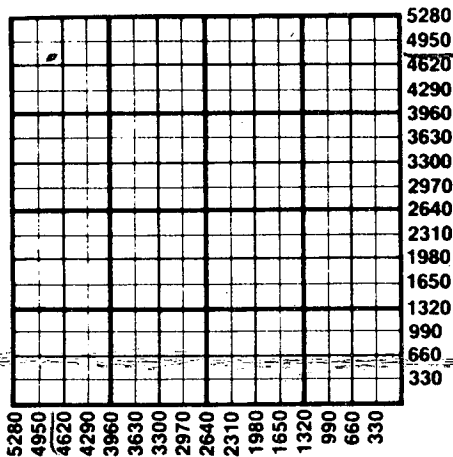

State Corporation Commission of Kansas
 Conservation Division
 200 Colorado Derby Building
 Wichita, Kansas 67202
 (316) 263-3238