

CARD MUST BE TYPED

# State of Kansas NOTICE OF INTENTION TO DRILL

CARD MUST BE SIGNED

(see rules on reverse side)

Starting Date: September 24 1984  
month day year

API Number 15-007-21,929-00-00  
150' East of  East  
C SW SW Sec 35 Twp 31 S, Rge 11  West  
(location)

OPERATOR: License # 5050  
Name Hummon Corporation  
Address 400 One Main Place  
City/State/Zip Wichita, Kansas 67202  
Contact Person Wilber Berg  
Phone 263-8521

660 Ft North from Southeast Corner of Section  
4515 Ft West from Southeast Corner of Section  
(Note: Locate well on Section Plat on reverse side)

CONTRACTOR: License # 5148  
Name Big-H Drilling, Inc.  
City/State Wichita, Kansas

Nearest lease or unit boundary line 660 feet.  
County Barber  
Lease Name Smith Well# 7-35

Well Drilled For: Well Class: Type Equipment:  
 Oil  Swd  Infield  Mud Rotary  
 Gas  Inj  Pool Ext.  Air Rotary  
 OWWO  Expl  Wildcat  Cable

Domestic well within 330 feet:  yes  no  
Municipal well within one mile:  yes  no

If OWWO: old well info as follows:

Operator

Well Name

Comp Date Old Total Depth

Projected Total Depth 3875 feet

Projected Formation at TD Lansing

Expected Producing Formations

Depth to Bottom of fresh water 100 feet  
Lowest usable water formation Salt Plain Slt  
Depth to Bottom of usable water 200 feet  
Surface pipe by Alternate: 1  2   
Surface pipe to be set 200 feet  
Conductor pipe if any required feet  
Ground surface elevation feet MSL  
This Authorization Expires ~~3-13-85~~ 3-13-85  
Approved By 9-13-84 KC

I certify that we will comply with K.S.A. 55-101, et seq., plus eventually plugging hole to K.C.C. specifications.

Date 9-12-84 Signature of Operator or Agent


Kenneth S. White Agent  
Title

mhc/JOHE 9/13/84

**Must be filed with the K.C.C. five (5) days prior to commencing well  
This card void if drilling not started within six (6) months of date received by K.C.C.**

**Important procedures to follow:**

**A Regular Section of Land  
1 Mile = 5,280 Ft.**

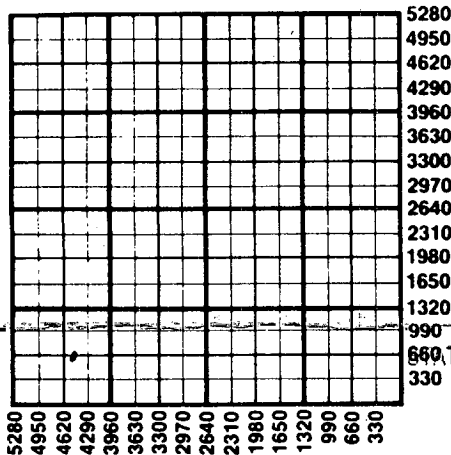

1. Notify District office before setting surface casing.
2. Set surface casing by circulating cement to the top.
3. File completion forms ACO-1 with K.C.C. within 90 days of well completion, following instructions on ACO-1, side 1, and including copies of wireline logs.
4. Notify District office 48 hours prior to old well workover or re-entry.
5. Prior to plugging, prepare a plugging plan, then obtain agreement from the appropriate district office for an approved plugging plan.
6. Submit plugging report (CP-4) to K.C.C. after plugging is completed.
7. Obtain an approved injection docket number before disposing of salt water.

8. Notify K.C.C. within 10 days when injection commences or terminates.  
 9. After completion, cement in the production pipe from below  
 any usable water to surface within 120 days of spud date.

RECEIVED  
 SEP 13 1984

CONSERVATION DIVISION  
 Wichita, Kansas

State Corporation Commission of Kansas  
 Conservation Division  
 200 Colorado Derby Building  
 Wichita, Kansas 67202  
 (316) 263-3238