

CARD MUST BE TYPED

State of Kansas  
**NOTICE OF INTENTION TO DRILL**

CARD MUST BE SIGNED

(see rules on reverse side)

Starting Date: 6/25/85  
month day year

API Number IS- 163-22,706-00-00

OPERATOR: License # 8061  
Name Oil Producers, Inc. of Kansas  
Address P.O. Box 8647  
City/State/Zip Wichita, Kansas 67208  
Contact Person John S. Weir  
Phone 316-681-0231

50' N & E of NW NE SE  East  
Sec. 35. Twp 8... S, Rge 17.  West  
(location)

2350 Ft North from Southeast Corner of Section  
1040 Ft West from Southeast Corner of Section  
(Note: Locate well on Section Plat on reverse side)

CONTRACTOR: License # 5122  
Name Woodman & Iannitti Drilling Co.  
City/State Wichita, Kansas

Nearest lease or unit boundary line 990 feet.  
County Rooks  
Lease Name Hrabe Well# 1

Well Drilled For: Well Class: Type Equipment:  
 Oil  Swd  Infield  Mud Rotary  
 Gas  Inj  Pool Ext.  Air Rotary  
 OWWO  Expl  Wildcat  Cable

Domestic well within 330 feet:  yes  no  
Municipal well within one mile:  yes  no

If OWWO: old well info as follows:

Operator .....  
Well Name .....  
Comp Date ..... Old Total Depth .....  
Projected Total Depth 3450 feet  
Projected Formation at TD Lansing  
Expected Producing Formations Lansing

Depth to Bottom of fresh water 50 feet  
Lowest usable water formation Dakota  
Depth to Bottom of usable water 800 feet  
Surface pipe by Alternate:  1  2  
Surface pipe to be set 200 feet  
Conductor pipe if any required ..... feet  
Ground surface elevation 1911 feet MSI  
This Authorization Expires 12-10-85

Approved By 6-10-85 *[Signature]*

I certify that we will comply with K.S.A. 55-101, et seq., plus eventually plugging hole to K.C.C. specifications.

Date 6/17/85 Signature of Operator or Agent


*[Signature: John S. Weir]*

Title President  
MHC/WOHE 6-10-85 Form C-1 4/84

Must be filed with the K.C.C. five (5) days prior to commencing well  
This card void if drilling not started within six (6) months of date received by K.C.C.

RECEIVED  
STATE CORPORATION COMMISSION  
JUN 10 1955  
CONSERVATION DIVISION  
Wichita, Kansas  
6/10/55

**A Regular Section of Land**  
**1 Mile = 5,280 Ft.**

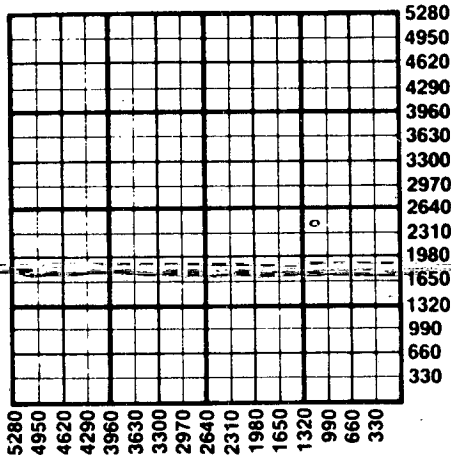

**Important procedures to follow:**

1. Notify District office before setting surface casing.
2. Set surface casing by circulating cement to the top.
3. File completion forms ACO-1 with K.C.C. within 90 days of well completion, following instructions on ACO-1, side 1, and including copies of wireline logs.
4. Notify District office 48 hours prior to old well workover or re-entry.
5. Prior to plugging, prepare a plugging plan, then obtain agreement from the appropriate district office for an approved plugging plan.
6. Submit plugging report (CP-4) to K.C.C. after plugging is completed.
7. Obtain an approved injection docket number before disposing of salt water.
8. Notify K.C.C. within 10 days when injection commences or terminates.
9. If an alternate 2 completion, cement in the production pipe from below any usable water to surface within 120 days of spud date.

**State Corporation Commission of Kansas**  
**Conservation Division**  
**200 Colorado Derby Building**  
**Wichita, Kansas 67202**  
**(316) 263-3238**