

CARD MUST BE TYPED

# NOTICE OF INTENTION TO DRILL

CARD MUST BE SIGNED

State of Kansas  
(see rules on reverse side)

Starting Date: .... April <sup>30<sup>th</sup></sup> ~~22~~, 1985 .....  
month day year

API Number 15- 163-22,679-00-00

OPERATOR: License # ~~4316~~ 4316

NE SW NW  
(location) Sec 25 Twp 8 S, Rge 18  East  West

Name Class Oil

Address 210 W 34th

City/State/Zip Hays Kansas ~~67665~~ 67401

Contact Person Tom Brown

Phone 434-7141

3630 Ft North from Southeast Corner of Section  
4290 Ft West from Southeast Corner of Section  
(Note: Locate well on Section Plat on reverse side)

CONTRACTOR: License # ~~9087~~ 9087

Name R & C Drilling Co Inc

City/State Hays, Ka

Nearest lease or unit boundary line 330 feet.  
County Rooks  
Lease Name Hazen-B Well# 1

<b>Well Drilled For:</b>	<b>Well Class:</b>	<b>Type Equipment:</b>
<input checked="" type="checkbox"/> Oil	<input type="checkbox"/> Infield	<input checked="" type="checkbox"/> Mud Rotary
<input type="checkbox"/> Gas	<input checked="" type="checkbox"/> Pool Ext.	<input type="checkbox"/> Air Rotary
<input type="checkbox"/> OWWO	<input type="checkbox"/> Wildcat	<input type="checkbox"/> Cable
<input type="checkbox"/> Swd		
<input type="checkbox"/> Inj		

Domestic well within 330 feet:  yes  no  
Municipal well within one mile:  yes  no

If OWWO: old well info as follows:

Operator .....

Well Name .....

Comp Date ..... Old Total Depth .....

Projected Total Depth 3450 feet

Projected Formation at TD Arbuckle

Expected Producing Formations Arbuckle

Depth to Bottom of fresh water 50 feet

Lowest usable water formation Dakota

Depth to Bottom of usable water 700 feet

Surface pipe by Alternate: 1  2

Surface pipe to be set 215 feet

Conductor pipe if any required None

Ground surface elevation 1987 feet MSL

This Authorization Expires 10-24-85

Approved By 4-24-85

I certify that we will comply with K.S.A. 55-101, et seq., plus eventually plugging hole to K.C.C. specifications.

Date 4-7-85 Signature of Operator or Agent *Thomas M. Brown*

Title CO/OWNER  
MICHAEL 4-24-85


Must be filed with the K.C.C. five (5) days prior to commencing well  
 This card void if drilling not started within six (6) months of date received by K.C.C.

RECEIVED  
 STATE CORPORATION COMMISSION  
 APR 24, 1985  
 APR 24 1985

**Important procedures to follow:**

CONSERVATION DIVISION  
 Wichita, Kansas

**A Regular Section of Land  
 1 Mile = 5,280 Ft.**

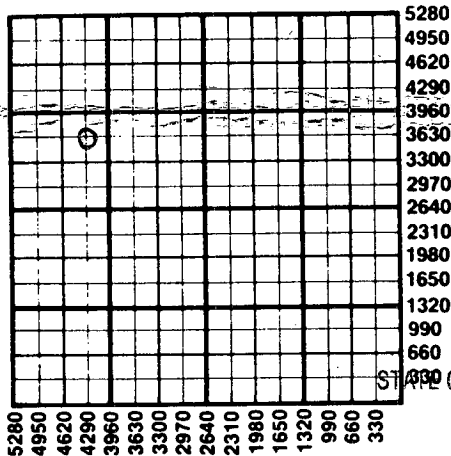

1. Notify District office before setting surface casing.
  2. Set surface casing by circulating cement to the top.
  3. File completion forms ACO-1 with K.C.C. within 90 days of well completion, following instructions on ACO-1, side 1, and including copies of wireline logs.
  4. ~~Notify District office 48 hours prior to old well workover or re-entry.~~
  5. Prior to plugging, prepare a plugging plan, then obtain agreement from the appropriate district office for an approved plugging plan.
  6. Submit plugging report (CP-4) to K.C.C. after plugging is completed.
  7. Obtain an approved injection docket number before disposing of salt water.
  8. Notify K.C.C. within 10 days when injection commences or terminates.
9. If an alternate 2 completion, cement in the production pipe from below any leaky water to surface within 120 days of spud date.

RECEIVED  
 STATE CORPORATION COMMISSION

APR 19 1985  
 APR 19, 1985  
 CONSERVATION DIVISION  
 Wichita, Kansas

State Corporation Commission of Kansas  
 Conservation Division  
 200 Colorado Derby Building  
 Wichita, Kansas 67202  
 (316) 263-3238