

NOTICE OF INTENTION TO DRILL

(see rules on reverse side)

Starting Date ... February ... 19 ... 1987 ... month day year

API Number 15- 003-12,775-00-00

OPERATOR: License # 4175

CN 1/2 NW NE Sec. 7 Twp. 23 S, Rg. 18 X East 4950 Ft. from South Line of Section 1980 Ft. from East Line of Section

Name Quest Development Co

Address 510 E. Jackson

City/State/Zip Iola, Ks 66749

Contact Person Harold Dvoracek

Phone 1-316-365-5862

(Note: Locate well on Section Plat on reverse side)

Nearest lease or unit boundary line 330 feet

County Anderson

Lease Name West Well # 1

CONTRACTOR: License # 6745

Name Donald G. Keys dba Auburn Drilling

City/State Colony, Ks 66015

Ground surface elevation 1023 feet MSL

Domestic well within 330 feet: yes no

Municipal well within one mile: yes no

Well Drilled For: Well Class: Type Equipment:

X Oil SWD Infield X Mud Rotary

Gas Inj Pool Ext Air Rotary

OWWO Expl X Wildcat Cable

Depth to bottom of fresh water 25

Depth to bottom of usable water 125

Surface pipe by Alternate: 1 2 X

Surface pipe planned to be set 40

Conductor pipe required none

Projected Total Depth 950 feet

Formation Cherokee

If OWWO: old well info as follows:

Operator

Well Name

Comp Date Old Total Depth

I certify that well will comply with K.S.A. 55-101, et seq., plus eventually plugging hole to KCC specifications.

Date 2-12-87 Signature of Operator or Agent

Harold Dvoracek Title Operator

For KCC Use:

Conductor Pipe Required feet; Minimum Surface Pipe Required 70 feet per Alt. #2

This Authorization Expires 8-12-87 Approved By 2-12-87


Handwritten signatures and initials at the bottom right of the page.

Must be filed with the K.C.C. five (5) days prior to commencing well  
This card void if drilling not started within six (6) months of date received by K.C.C.

**Important procedures to follow:**

1. Notify District office before setting surface casing.
2. Set surface casing by circulating cement to the top.
3. File completion forms ACO-1 with K.C.C. within 90 days of well completion, following instructions on ACO-1, side 1, and including copies of wireline logs.
4. Notify District office 48 hours prior to old well workover or re-entry.
5. Prior to filing Intent, prepare a proposed plugging plan in case well is D & A, then obtain approval of plan when calling district office prior to setting surface pipe.
6. Submit plugging report (CP-4) to K.C.C. after plugging is completed.
7. Obtain an approved injection docket number before disposing of salt water.
8. Notify K.C.C. within 10 days when injection commences or terminates.
9. If an alternate 2 completion, cement in the production pipe from below any usable water to surface within 120 days of spud date.

**A Regular Section of Land  
1 Mile = 5,280 Ft.**

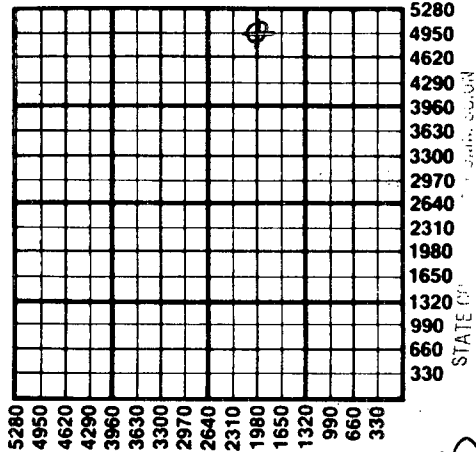

2-12-87

FEB 12 1987

CONSERVATION DIVISION  
Wichita, Kansas

State Corporation Commission of Kansas  
Conservation Division  
200 Colorado Derby Building  
Wichita, Kansas 67202  
(316) 263-3238