

CARD MUST BE TYPED

State of Kansas

CARD MUST BE SIGNED

NOTICE OF INTENTION TO DRILL

(see rules on reverse side)

OWWO
-00-01

Expected Spud Date. September 15, 1987
month day year

API Number 15— 173-20,601-A

OPERATOR: License # 5037
Name Pan-Western Petroleum, Inc.
Address Board of Trade Center, Suite 501
120 So. Market
City/State/Zip Wichita, Kansas 67202
Contact Person Toby Elster
Phone 316-263-0542

SE. NW. NW. Sec. 17 Twp. 26 S, Rg. 2 East
4290 ~~XXXX~~
4290 Ft. from South Line of Section
Ft. from East Line of Section

(Note: Locate well on Section Plat on reverse side)

CONTRACTOR: License # 5420
Name White & Ellis Drilling, Inc.
City/State El Dorado, Kansas

Nearest lease or unit boundary line 990 feet
County Sedgwick
Lease Name Galyardt Well # "1" A

Well Drilled For: Well Class: Type Equipment:
 Oil Storage Infield Mud Rotary
 Gas Inj Pool Ext. Air Rotary
 OWWO Expl Wildcat Cable

Ground surface elevation 1432 feet MSL
Domestic well within 330 feet: yes no
Municipal well within one mile: yes no

If OWWO: old well info as follows:
Operator Wiley Ash, Jr.
Well Name Galyardt No. 9
Comp Date 1-12-84 Old Total Depth 3491'

Depth to bottom of fresh water 50
Depth to bottom of usable water 200
Surface pipe by Alternate: 1 2
Surface pipe planned to be set 212'
Conductor pipe required
Projected Total Depth 3491' feet
Formation

I certify that well will comply with K.S.A. 55-101, et seq., plus eventually plugging hole to KCC specifications.
Date August 26, 1987 Signature of Operator or Agent Toby Elster Title President


For KCC Use:
Conductor Pipe Required _____ feet; Minimum Surface Pipe Required _____ feet per Alt. 1
This Authorization Expires 3-10-88 Effective 9-15-87 Approved By Pat 9-10-87 212

Must be filed with the K.C.C. five (5) days prior to commencing well
 This card void if drilling not started within six (6) months of date received by K.C.C.

Important procedures to follow:

1. Notify District office before setting surface casing.
2. Set surface casing by circulating cement to the top.
3. File completion forms ACO-1 with K.C.C. within 120 days of well spud date, following instructions on ACO-1, side 1, and including copies of wireline logs.
4. Notify District office 48 hours prior to old well workover or re-entry.
5. Prior to filing Intent, prepare a proposed plugging plan in case well is D & A, then obtain approval of plan when calling district office prior to setting surface pipe.
6. Submit plugging report (CP-4) to K.C.C. after plugging is completed.
7. Obtain an approved injection docket number before disposing of salt water.
8. Notify K.C.C. within 10 days when injection commences or terminates.
9. If an alternate 2 completion, cement in the production pipe from below any usable water to surface within 120 days of spud date.

A Regular Section of Land
1 Mile = 5,280 Ft.

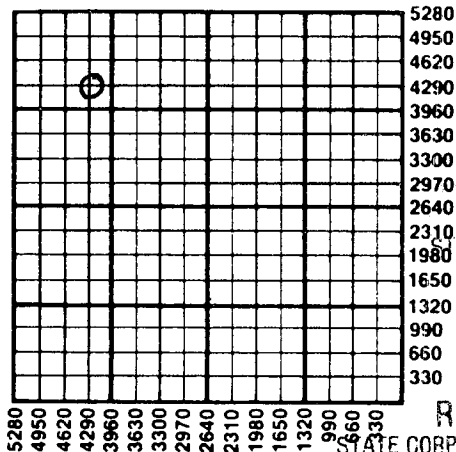

RECEIVED
 STATE CORPORATION COMMISSION
 AUG 27 1987
 8-27-87
 CONSERVATION DIVISION
 WICHITA, KANSAS
 RECEIVED
 STATE CORPORATION COMMISSION

SEP 10 1987
 9-10-87
 CONSERVATION DIVISION
 WICHITA, KANSAS

State Corporation Commission of Kansas
 Conservation Division
 200 Colorado Derby Building
 Wichita, Kansas 67202-1212
 (316) 263-3238