

CARD MUST BE TYPED

State of Kansas
NOTICE OF INTENTION TO DRILL
(see rules on reverse side)

CARD MUST BE SIGNED

Starting Date: 9 4 85
month day year

API Number 15- 173-20,734-00-00

OPERATOR: License # ... 5476
Name .. DNB Drilling, Inc
Address .. 535 N. Oliver
City/State/Zip Wichita, KS 67208
Contact Person James Donelson, Jr
Phone (316) 687-5471

NW.. NE.. NE. Sec 18. Twp 26 S. S, Rge 2. ... East
(location) West
4950 Ft North from Southeast Corner of Section
990 Ft West from Southeast Corner of Section
(Note: Locate well on Section Plat on reverse side)

CONTRACTOR: License # 5302
Name .. Red Tiger Drilling Co.
City/State Wichita, Kansas

Nearest lease or unit boundary line .. 330' feet.
County ... Sedgwick
Lease Name .. Sample "A" Well# .. 2
Domestic well within 330 feet : yes no
Municipal well within one mile : yes no

Well Drilled For: Well Class: Type Equipment:
 Oil Swd Infield Mud Rotary
 Gas Inj Pool Ext. Air Rotary
 OWWO Expl Wildcat Cable

Depth to Bottom of fresh water .. 200 50 feet
Lowest usable water formation
Depth to Bottom of usable water .. 200 feet
Surface pipe by Alternate : 1 2
Surface pipe to be set .. 200 feet
Conductor pipe if any required feet
Ground surface elevation .. 1426 feet MSL
This Authorization Expires .. 2-29-86
Approved By .. 8-29-85

If OWWO: old well info as follows:

Operator
Well Name
Comp Date Old Total Depth
Projected Total Depth .. 3600 feet
Projected Formation at TD .. Simpson
Expected Producing Formations .. Simpson

I certify that we will comply with K.S.A. 55-101, et seq., plus eventually plugging hole to K.C.C. specifications.

Date 8-29-85 Signature of Operator or Agent *James Donelson Jr* Title *Office Manager*
Rest for KOME

Must be filed with the K.C.C. five (5) days prior to commencing well
 This card void if drilling not started within six (6) months of date received by K.C.C.

RECEIVED
 STATE CORPORATION COMMISSION


8-29-85
 AUG 29 1985

Important procedures to follow :

**A Regular Section of Land
 1 Mile = 5,280 Ft.**

CONSERVATION DIVISION
 Wichita, Kansas

1. Notify District office before setting surface casing.
2. Set surface casing by circulating cement to the top.
3. File completion forms ACO-1 with K.C.C. within 90 days of well completion, following instructions on ACO-1, side 1, and including copies of wireline logs.
4. Notify District office 48 hours prior to old well workover or re-entry.
5. Prior to plugging, prepare a plugging plan, then obtain agreement from the appropriate district office for an approved plugging plan.
6. Submit plugging report (CP-4) to K.C.C. after plugging is completed.
7. Obtain an approved injection docket number before disposing of salt water.
8. Notify K.C.C. within 10 days when injection commences or terminates.
9. If an alternate 2 completion, cement in the production pipe from below any usable water to surface within 120 days of spud date.

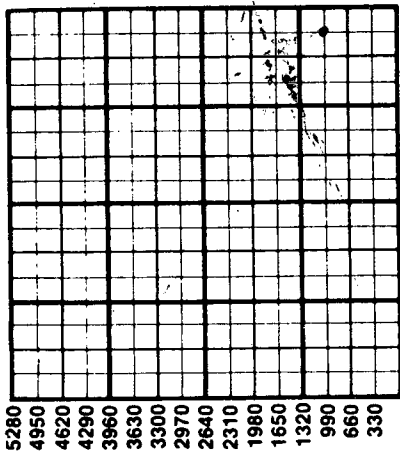

**State Corporation Commission of Kansas
 Conservation Division
 200 Colorado Derby Building
 Wichita, Kansas 67202
 (316) 263-3238**

CARD MUST BE TYPED

State of Kansas
NOTICE OF INTENTION TO DRILL
(see rules on reverse side)

CARD MUST BE SIGNED

Starting Date:9.....4.....85.....
month day year

API Number 15- **173-20,734**

OPERATOR: License # **5476**
Name **DNB Drilling, Inc.**
Address **535 N. Oliver**
City/State/Zip **Wichita, KS. 67208**
Contact Person **James Donelson, Jr.**
Phone **(316) 687-5471**

NW.. NE.. NE. Sec **18**. Twp **26S**. S. Rge **2**... East
(location) West
4950..... Ft North from Southeast Corner of Section
990..... Ft West from Southeast Corner of Section
(Note: Locate well on Section Plat on reverse side)

CONTRACTOR: License # **5302**
Name **Red Tiger Drilling Co.**
City/State **Wichita, Kansas**

Nearest lease or unit boundary line **330'**..... feet.
County **Sedgwick**
Lease Name **Sample "A"**..... Well# **2**
Domestic well within 330 feet: yes no
Municipal well within one mile: yes no

Well Drilled For: Well Class: Type Equipment:
 Oil Swd Infield Mud Rotary
 Gas Inj Pool Ext. Air Rotary
 OWWO Expl Wildcat Cable

*Plugged
9/19/85*

If OWWO: old well info as follows:
Operator
Well Name
Comp Date Old Total Depth
Projected Total Depth **3600**..... feet
Projected Formation at TD **Simpson**
Expected Producing Formations **Simpson**

Depth to Bottom of fresh water **200.50**..... feet
Lowest usable water formation
Depth to Bottom of usable water **200**..... feet
Surface pipe by Alternate: 1 2
Surface pipe to be set **200'**..... feet
Conductor pipe if any required feet
Ground surface elevation **1426**..... feet MSL
This Authorization Expires **2-29-86**
Approved By **8-29-85** *[Signature]*

I certify that we will comply with K.S.A. 55-101, et seq., plus eventually plugging hole to K.C.C. specifications.

Date **8-29-85**..... Signature of Operator or Agent *[Signature]* Title *[Signature]*
Date **8-29-85**..... Signature of Operator or Agent

RECEIVED
STATE CORPORATION COMMISSION

DEC 2 1985

CONSERVATION DIVISION
Wichita, Kansas