

CARD MUST BE TYPED

State of Kansas
NOTICE OF INTENTION TO DRILL

CARD MUST BE SIGNED

(see rules on reverse side)

Starting Date: September 7 1985
month day year

API Number 15- 163-22,732-00-00

OPERATOR: License # 5537
Name Kenny Brown Enterprises
Address Drawer 340
City/State/Zip Plainville, Kansas 67663
Contact Person Kenneth O Brown
Phone 913-434-7236

SW/4 SW SW Sec 31.. Twp . 8 . S, Rge 17.. East
(location) West

..... 330 Ft North from Southeast Corner of Section
..... 4950 Ft West from Southeast Corner of Section
(Note: Locate well on Section Plat on reverse side)

CONTRACTOR: License # 5145
Name Dreiling Oil, Inc.
City/State Victoria, Kansas 67671

Nearest lease or unit boundary line 330 feet.
County Rooks
Lease Name Dopita J Well# 5

Well Drilled For: Well Class: Type Equipment:
 Oil Swd Infield Mud Rotary
 Gas Inj Pool Ext. Air Rotary
 OWWO Expl Wildcat Cable

Domestic well within 330 feet : yes no
Municipal well within one mile : yes no

If OWWO: old well info as follows:
Operator
Well Name
Comp Date Old Total Depth
Projected Total Depth feet
Projected Formation at TD
Expected Producing Formations

Depth to Bottom of fresh water 125 feet
Lowest usable water formation Dakota
Depth to Bottom of usable water 800 feet
Surface pipe by Alternate : 1 2
Surface pipe to be set 200 plus feet
Conductor pipe if any required feet
Ground surface elevation 2001 feet MSL
This Authorization Expires 2-1-86
Approved By 8-1-85 *PCB for KOBE*

I certify that we will comply with K.S.A. 55-101, et seq., plus eventually plugging hole to K.C.C. specifications.

Date 7-30-85 Signature of Operator or Agent Kenneth O Brown Title


Owner & Operator

Must be filed with the K.C.C. five (5) days prior to commencing well
This card void if drilling not started within six (6) months of date received by K.C.C.

UNIVERSITY OF KANSAS
WICHITA, KANSAS
CONSERVATION DIVISION
1985

AUG 1
RECEIVED
STATE CORPORATION COMMISSION
8/1/85

A Regular Section of Land
1 Mile = 5,280 Ft.

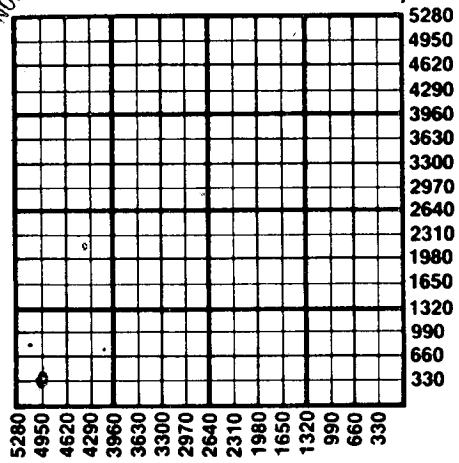

Important procedures to follow :

1. Notify District office before setting surface casing:
2. Set surface casing by circulating cement to the top.
3. File completion forms ACO-1 with K.C.C. within 90 days of well completion, following instructions on ACO-1, side 1, and including copies of wireline logs.
4. Notify District office 48 hours prior to old well workover or re-entry.
5. Prior to plugging, prepare a plugging plan, then obtain agreement from the appropriate district office for an approved plugging plan.
6. Submit plugging report (CP-4) to K.C.C. after plugging is completed.
7. Obtain an approved injection docket number before disposing of salt water.
8. Notify K.C.C. within 10 days when injection commences or terminates.
9. If an alternate 2 completion, cement in the production pipe from below any usable water to surface within 120 days of spud date.

State Corporation Commission of Kansas
Conservation Division
200 Colorado Derby Building
Wichita, Kansas 67202
(316) 263-3238