

CARD MUST BE TYPED

State of Kansas
NOTICE OF INTENTION TO DRILL

CARD MUST BE SIGNED

(see rules on reverse side)

Starting Date: August 29 1985
month day year

API Number 15- 163-22,733-00-00

OPERATOR: License # 5537

No. S.E. SW/4. Sec . 31. Twp . 8. S, Rge . 17. East West
(location)

Name ... Kenny Brown Enterprises

Address ... Drawer 340

City/State/Zip ... Plainville, Kansas 67663

Contact Person ... Kenneth O. Brown

Phone ... 913-434-7236

... 990 ... Ft North from Southeast Corner of Section

... 3630 ... Ft West from Southeast Corner of Section

(Note: Locate well on Section Plat on reverse side)

CONTRACTOR: License # 5145

Nearest lease or unit boundary line ... 330 ... feet

Name ... Dreiling Oil, Inc.

County ... Books

City/State ... Victoria, Kansas 67671

Lease Name ... Dopita B. Well# ... 7

Well Drilled For: Well Class: Type Equipment:

Domestic well within 330 feet: yes no

Oil Swd Infield Mud Rotary

Municipal well within one mile: yes no

Gas Inj Pool Ext. Air Rotary

Depth to Bottom of fresh water ... 125 ... feet

OWWO Expl Wildcat Cable

Lowest usable water formation ... Dakota

If OWWO: old well info as follows:

Depth to Bottom of usable water ... 800 ... feet

Operator

Surface pipe by Alternate: 1 2

Well Name

Surface pipe to be set ... 200 plus ... feet

Comp Date Old Total Depth

Conductor pipe if any required ... feet

Projected Total Depth ... feet

Ground surface elevation ... 1993 ... feet MSL

Projected Formation at TD

This Authorization Expires ... 2-1-86

Expected Producing Formations

Approved By ... 8-1-85

I certify that we will comply with K.S.A. 55-101, et seq., plus eventually plugging hole to K.C.C. specifications.

REC'D FOR KONE

Date 7-30-85

Signature of Operator or Agent Kenneth O. Brown Title

Owner & Operator


CONSERVATION DIVISION
 WICHITA, KANSAS
 1985

AUG 1

58/1/8

**A Regular Section of Land
 1 Mile = 5,280 Ft.**

**Must be filed with the K.C.C. five (5) days prior to commencing well
 This card void if drilling not started within six (6) months of date received by K.C.C.**

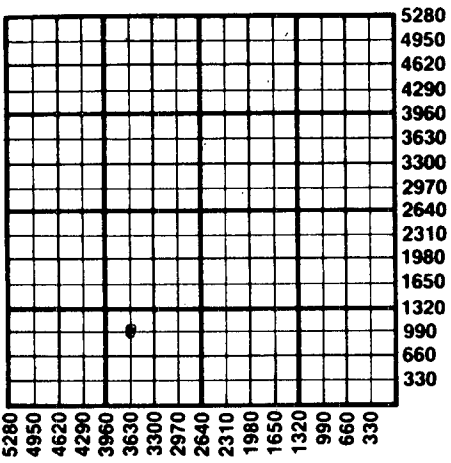

Important procedures to follow :

1. Notify District office before setting surface casing.
2. Set surface casing by circulating cement to the top.
3. File completion forms ACO-1 with K.C.C. within 90 days of well completion, following instructions on ACO-1, side 1, and including copies of wireline logs.
4. Notify District office 48 hours prior to old well workover or re-entry.
5. Prior to plugging, prepare a plugging plan, then obtain agreement from the appropriate district office for an approved plugging plan.
6. Submit plugging report (CP-4) to K.C.C. after plugging is completed.
7. Obtain an approved injection docket number before disposing of salt water.
8. Notify K.C.C. within 10 days when injection commences or terminates.
9. If an alternate 2 completion, cement in the production pipe from below any usable water to surface within 120 days of spud date.

**State Corporation Commission of Kansas
 Conservation Division
 200 Colorado Derby Building
 Wichita, Kansas 67202
 (316) 263-3238**