

CARD MUST BE TYPED

State of Kansas  
**NOTICE OF INTENTION TO DRILL**  
(see rules on reverse side)

CARD MUST BE SIGNED

Starting Date: August 22 1985  
month day year

API Number 15- 163-22,734 0000

OPERATOR: License # 5537  
Name Kenny Brown Enterprises  
Address Drawer 340  
City/State/Zip Plainville, Kansas 67663  
Contact Person Kenneth O Brown

SE/4 (location) Sec 31 Twp 8 S, Rge 17  East  West

380 Ft North from Southeast Corner of Section  
1320 Ft West from Southeast Corner of Section  
(Note: Locate well on Section Plat on reverse side)

Phone 913-434-7236  
CONTRACTOR: License # 5145  
Name Dreiling Oil Inc.  
City/State Victoria, Kansas 67671

Nearest lease or unit boundary line 380 feet.

County Rooks  
Lease Name Dopita A Well# 10

Well Drilled For: Well Class: Type Equipment:  
 Oil  Swd  Infield  Mud Rotary  
 Gas  Inj  Pool Ext.  Air Rotary  
 OWWO  Expl  Wildcat  Cable

Domestic well within 330 feet:  yes  no  
Municipal well within one mile:  yes  no

If OWWO: old well info as follows:  
Operator  
Well Name  
Comp Date Old Total Depth  
Projected Total Depth  
Projected Formation at TD  
Expected Producing Formations

Depth to Bottom of fresh water 125 feet  
Lowest usable water formation Dakota  
Depth to Bottom of usable water 800 feet  
Surface pipe by Alternate: 1  2   
Surface pipe to be set 200 plus feet  
Conductor pipe if any required feet  
Ground surface elevation 1933 feet MSL  
This Authorization Expires 2-1-86  
Approved By 8-1-85

I certify that we will comply with K.S.A. 55-101, et seq., plus eventually plugging hole to K.C.C. specifications.

Date 7-30-85 Signature of Operator or Agent Kenneth O Brown Title Owner & Operator


Act for K.C.C.

Must be filed with the K.C.C. five (5) days prior to commencing well  
This card void if drilling not started within six (6) months of date received by K.C.C.

**Important procedures to follow :**

1. Notify District office before setting surface casing.
2. Set surface casing by circulating cement to the top.
3. File completion forms ACO-1 with K.C.C. within 90 days of well completion, following instructions on ACO-1, side 1, and including copies of wireline logs. \*
4. Notify District office 48 hours prior to old well workover or re-entry.
5. Prior to plugging, prepare a plugging plan, then obtain agreement from the appropriate district office for an approved plugging plan.
6. Submit plugging report (CP-4) to K.C.C. after plugging is completed.
7. Obtain an approved injection docket number before disposing of salt water.
8. Notify K.C.C. within 10 days when injection commences or terminates.
9. If an alternate 2 completion, cement in the production pipe from below any usable water to surface within 120 days of spud date.

**Regular Section of Land**  
**1 Mile = 5,280 Ft.**

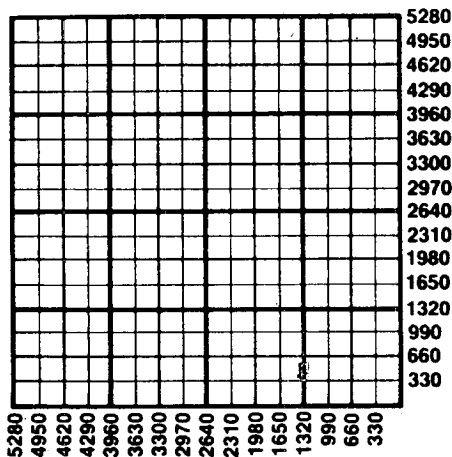

**State Corporation Commission of Kansas**  
**Conservation Division**  
**200 Colorado Derby Building**  
**Wichita, Kansas 67202**  
**(316) 263-3238**

CONSERVATION DIVISION  
WICHITA, KANSAS  
AUG 1 1985  
STATE CORPORATION COMMISSION  
8/1/85