

NOTICE OF INTENTION TO DRILL

(see rules on reverse side)

Expected Spud Date. 10-15-87
month day year

API Number 15-099-22,625-00-00 ✓

OPERATOR: License # 7208
Name Lorraine Cleaver
Address Box 54
City/State/Zip Piqua, KS 66761
Contact Person Lorraine Cleaver
Phone 316-468-2050

C E2SE SE Sec. 18 Twp. 33S, Rg. 18 East
660 Ft. from South Line of Section
330 Ft. from East Line of Section

(Note: Locate well on Section Plat on reverse side)

CONTRACTOR: License # 5379
Name Kephart Drilling Inc.
City/State R.R. # 1 Thayer, Kansas

Nearest lease or unit boundary line 330 feet
County Labette
Lease Name Ralph E. Bussman Well # 3

Well Drilled For: Well Class: Type Equipment:
 Oil Storage Infield Mud Rotary
 Gas Inj Pool Ext. Air Rotary
 OWWO Expl Wildcat Cable

Ground surface elevation na feet MSL
Domestic well within 330 feet: yes no
Municipal well within one mile: yes no

If OWWO: old well info as follows:
Operator _____
Well Name _____
Comp Date _____ Old Total Depth _____

Depth to bottom of fresh water 20
Depth to bottom of usable water 150
Surface pipe by Alternate: 1 2
Surface pipe planned to be set 20
Conductor pipe required _____
Projected Total Depth 700 feet
Formation _____

I certify that well will comply with K.S.A. 55-101, et seq., plus eventually plugging hole to KCC specifications.
Date 9-28-87 Signature of Operator or Agent Charlotta Kephart Title Agent

For KCC Use:
Conductor Pipe Required _____ feet; Minimum Surface Pipe Required _____ feet per Alt. 20
This Authorization Expires 4-15-88 Approved By [Signature] 10-15-87


EFFECTIVE DATE: 10-20-87

Must be filed with the K.C.C. five (5) days prior to commencing well
This card void if drilling not started within six (6) months of date received by K.C.C.

Important procedures to follow:

1. Notify District office before setting surface casing.
2. Set surface casing by circulating cement to the top.
3. File completion forms ACO-1 with K.C.C. within 120 days of well spud date, following instructions on ACO-1, side 1, and including copies of wireline logs.
4. Notify District office 48 hours prior to old well workover or re-entry.
Prior to filing Intent, prepare a proposed plugging plan in case well is D & A, then obtain approval of plan when calling district office prior to setting surface pipe.
Submit plugging report (CP-4) to K.C.C. after plugging is completed.
7. Obtain an approved injection docket number before disposing of salt water.
8. Notify K.C.C. within 10 days when injection commences or terminates.
9. If an alternate 2 completion, cement in the production pipe from below any usable water to surface within 120 days of spud date.

A Regular Section of Land
1 Mile = 5,280 Ft.

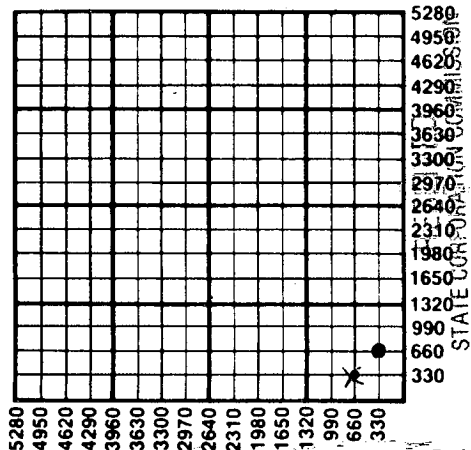

OCT 15 1987

CONSERVATION DIVISION
Wichita, Kansas

State Corporation Commission of Kansas
Conservation Division
200 Colorado Derby Building
Wichita, Kansas 67202-1212
(316) 263-3238

16-15-87