

CARD MUST BE TYPED

State of Kansas
NOTICE OF INTENTION TO DRILL
(see rules on reverse side)

CARD MUST BE SIGNED

Starting Date: October 21, 1984

API Number 15- 099-22,199-00-00

month day year
9897

SE SW SE 21 33 19 East
..... (location) Sec Twp S, Rge West

OPERATOR: License # Alumni Oil Company

330 Ft North from Southeast Corner of Section
1650 Ft West from Southeast Corner of Section
(Note: Locate well on Section Plat on reverse side)

Name P.O. Box 5660, 1801 Broadway, Ste. 1201

Address Denver, Colorado 80217

City/State/Zip Lee Mossel

Contact Person (303) 298-0722; (303) 751-9589

Phone 5379

CONTRACTOR: License # Rephart Drilling Inc.

Name R.R. 1, Box 68A, Thayer, KS. 66776

City/State

Nearest lease or unit boundary line 330 feet.
County Labeete
Lease Name Kessler Well# 21-34A

Well Drilled For: Oil Swd Infield Mud Rotary

Gas Inj Pool Ext. Air Rotary

OWWO Expl Wildcat Cable

Domestic well within 330 feet: yes no
Municipal well within one mile: yes no

Depth to Bottom of fresh water None feet
Lowest usable water formation None
Depth to Bottom of usable water 150 feet
Surface pipe by Alternate: 1 2 20
Surface pipe to be set None feet
Conductor pipe if any required None feet
Ground surface elevation feet MSL.

If OWWO: old well info as follows:
Operator

Well Name

Comp Date 850 Old Total Depth

Projected Total Depth Mississippi Lime feet

Projected Formation at TD Mississippi Lime, Bartlesville

Expected Producing Formations

This Authorization Expires 4-9-85
Approved By 10-9-85 *Lee Mossel*

I certify that we will comply with K.S.A. 55-101, et seq., plus eventually plugging hole to K.C.C. specifications.


Date 10/3/84 Signature of Operator or Agent Lee Mossel Title

General Manager

Must be filed with the K.C.C. five (5) days prior to commencing well
 This card void if drilling not started within six (6) months of date received by K.C.C.

Important procedures to follow:

A Regular Section of Land
 1 Mile = 5,280 Ft.

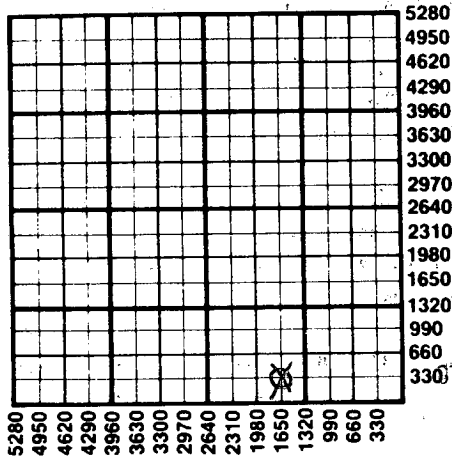

1. Notify District office before setting surface casing.
2. Set surface casing by circulating cement to the top.
3. File completion forms ACO-1 with K.C.C. within 90 days of well completion, following instructions on ACO-1, side 1, and including copies of wireline logs.
4. Notify District office 48 hours prior to old well workover or re-entry.
5. Prior to plugging, prepare a plugging plan, then obtain agreement from the appropriate district office for an approved plugging plan.
6. Submit plugging report (CP-4) to K.C.C. after plugging is completed.
7. Obtain an approved injection docket number before disposing of salt water.
8. Notify K.C.C. within 10 days when injection commences or terminates.
9. If an alternate 2 completion, cement in the production pipe from below any usable water to surface within 120 days of spud date.

RECEIVED

STATE CORPORATION COMMISSION

OCT 09 1984

CONSERVATION DIVISION
 Wichita, Kansas

State Corporation Commission of Kansas
 Conservation Division
 200 Colorado Derby Building
 Wichita, Kansas 67202
 (316) 263-3238

10-9-84