

CARD MUST BE TYPED

State of Kansas
NOTICE OF INTENTION TO DRILL

CARD MUST BE SIGNED

(see rules on reverse side)

Starting Date: 3/28 85
month day year

API Number 15- 125-27,672-00-00

OPERATOR: License # 6086
Name The Production Team, Inc.
Address Box 785
City/State/Zip Independence, KS 67301
Contact Person Alex Davies
Phone 316 331 2951

Ely NW
N 2 NE/4 Sec 2 Twp 34 S, Rge 13
(location) East West

CONTRACTOR: License # 5805
Name Windgate Oil
City/State Independence, KS 67301

4620 Ft North from Southeast Corner of Section
1815 Ft West from Southeast Corner of Section
(Note: Locate well on Section Plat on reverse side)

Well Drilled For: Well Class: Type Equipment:
 Oil Swd Infield Mud Rotary
 Gas Inj Pool Ext. Air Rotary
 OWWO Expl Wildcat Cable

Nearest lease or unit boundary line 660 feet.
County Montgomery
Lease Name Mann AB Well# 14
Domestic well within 330 feet: yes no
Municipal well within one mile: yes no

If OWWO: old well info as follows:
Operator
Well Name
Comp Date Old Total Depth
Projected Total Depth 650 feet
Projected Formation at TD
Expected Producing Formations

Depth to Bottom of fresh water 100 feet
Lowest usable water formation
Depth to Bottom of usable water 175 feet
Surface pipe by Alternate: 1 2
Surface pipe to be set 20 feet
Conductor pipe if any required feet
Ground surface elevation feet MSL.
This Authorization Expires 9-27-85
Approved By J-27-85 *Ra*

I certify that we will comply with K.S.A. 55-101, et seq., plus eventually plugging hole to K.C.C. specifications.


Date 3/27/85 Signature of Operator or Agent Raquel Robles Title As Agent

Form C-1 4/84
MAHC/UDHE 3-27-85

**Must be filed with the K.C.C. five (5) days prior to commencing well
This card void if drilling not started within six (6) months of date received by K.C.C.**

Important procedures to follow:

**A Regular Section of Land
1 Mile = 5,280 Ft.**

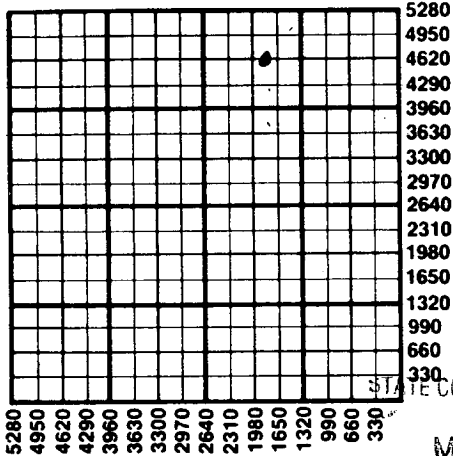

1. Notify District office before setting surface casing.
2. Set surface casing by circulating cement to the top.
3. File completion forms ACO-1 with K.C.C. within 90 days of well completion, following instructions on ACO-1, side 1, and including copies of wireline logs.
4. Notify District office 48 hours prior to old well workover or re-entry.
5. Prior to plugging, prepare a plugging plan, then obtain agreement from the appropriate district office for an approved plugging plan.
6. Submit plugging report (CP-4) to K.C.C. after plugging is completed.
7. Obtain an approved injection docket number before disposing of salt water.
8. Notify K.C.C. within 10 days when injection commences or terminates.

RECEIVED

of an alternate 2 completion, cement in the production pipe from below any usable water to surface within 120 days of spud date.

STATE CORPORATION COMMISSION

MAR 27 1985

CONSERVATION DIVISION
Wichita, Kansas

**State Corporation Commission of Kansas
Conservation Division
200 Colorado Derby Building
Wichita, Kansas 67202
(316) 263-3238**

3-27-85