

CARD MUST BE TYPED

State of Kansas  
**NOTICE OF INTENTION TO DRILL**  
(see rules on reverse side)

CARD MUST BE SIGNED

Starting Date: 34 28 85  
month day year

API Number 15- 125-27674-00-00

OPERATOR: License # 6086

NW/4  
NE/4 (Location)  
Sec . . . 2 Twp . . . 34 S, Rge . . . 13  East  West

Name The Production Team, Inc.

Address Box 785

City/State/Zip Independence, KS 67301

Contact Person Alex Davies

Phone 316 331 2951

495.0... Ft North from Southeast Corner of Section  
219.0... Ft West from Southeast Corner of Section  
(Note: Locate well on Section Plat on reverse side)

CONTRACTOR: License # 5805

Name Windgate Oil

City/State Independence, KS 67301

Nearest lease or unit boundary line 330 feet.  
County Montgomery

Lease Name Mann AB Well# 16

Well Drilled For: Well Class: Type Equipment:  
 Oil  Swd  Infield  Mud Rotary  
 Gas  Inj  Pool Ext.  Air Rotary  
 OWWO  Expl  Wildcat  Cable

Domestic well within 330 feet:  yes  no  
Municipal well within one mile:  yes  no

If OWWO: old well info as follows:

Depth to Bottom of fresh water 100 feet  
Lowest usable water formation  
Depth to Bottom of usable water 175 feet  
Surface pipe by Alternate: 1  2   
Surface pipe to be set 20 feet  
Conductor pipe if any required  
Ground surface elevation  
This Authorization Expires 9-27-85  
Approved By 3-27-85 *Rc*

Operator  
Well Name  
Comp Date Old Total Depth  
Projected Total Depth 650 feet  
Projected Formation at TD  
Expected Producing Formations

I certify that we will comply with K.S.A. 55-101, et seq., plus eventually plugging hole to K.C.C. specifications.


Date 3/27/85 Signature of Operator or Agent Raquel Robles Title As Agent

MHC/40HE 3-27-85

Must be filed with the K.C.C. five (5) days prior to commencing well  
This card void if drilling not started within six (6) months of date received by K.C.C.

**Important procedures to follow :**

**A Regular Section of Land**  
1 Mile = 5,280 Ft.

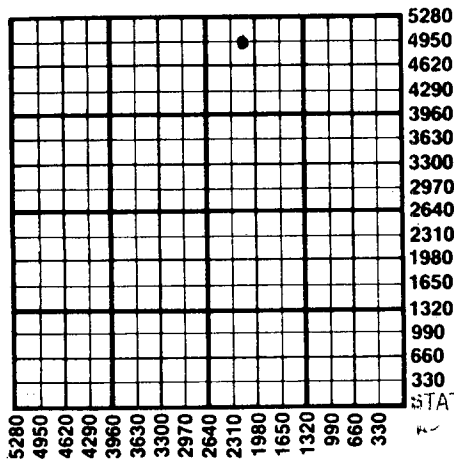

1. Notify District office before setting surface casing.
2. Set surface casing by circulating cement to the top.
3. File completion forms ACO-1 with K.C.C. within 90 days of well completion, following instructions on ACO-1, side 1, and including copies of wireline logs.
4. Notify District office 48 hours prior to old well workover or re-entry.
5. Prior to plugging, prepare a plugging plan, then obtain agreement from the appropriate district office for an approved plugging plan.
6. Submit plugging report (CP-4) to K.C.C. after plugging is completed.
7. Obtain an approved injection docket number before disposing of salt water.
8. Notify K.C.C. within 10 days when injection commences or terminates.
9. If an alternate 2 completion, cement in the production pipe from below any usable water to surface within 120 days of spud date.

RECEIVED  
STATE CORPORATION COMMISSION

MAR 27 1985

CONSERVATION DIVISION  
Wichita, Kansas

State Corporation Commission of Kansas  
Conservation Division  
200 Colorado Derby Building  
Wichita, Kansas 67202  
(316) 263-3238

3-27-85