

CARD MUST BE TYPED

# State of Kansas NOTICE OF INTENTION TO DRILL

CARD MUST BE SIGNED

(see rules on reverse side)

Starting Date: 8 29 1985  
month day year

API Number 15- 125-27,986-00-00

OPERATOR: License # 8972  
Name Robert Hopkins  
Address P.O. Box 310  
City/State/Zip Sedan, K.S. 67361  
Contact Person Robert Hopkins  
Phone 316.725-5602

SE NE SW Sec 2 Twp 34 S, Rge 13  
(location)  East  West

1650 Ft North from Southeast Corner of Section  
2970 Ft West from Southeast Corner of Section  
(Note: Locate well on Section Plat on reverse side)

CONTRACTOR: License #  
Name Unknown  
City/State

Nearest lease or unit boundary line 330 feet.  
County Montgomery  
Lease Name D. Ball Well# 56

|  |   |  |
|--|---|--|
| <b>Well Drilled For:</b>   | <b>Well Class:</b>                          | <b>Type Equipment:</b>                         |
| <input checked="" type="checkbox"/> Oil <input type="checkbox"/> Swd | <input checked="" type="checkbox"/> Infield | <input checked="" type="checkbox"/> Mud Rotary |
| <input type="checkbox"/> Gas <input type="checkbox"/> Inj            | <input type="checkbox"/> Pool Ext.          | <input type="checkbox"/> Air Rotary            |
| <input type="checkbox"/> OWWO <input type="checkbox"/> Expl          | <input type="checkbox"/> Wildcat            | <input type="checkbox"/> Cable                 |

Domestic well within 330 feet:  yes  no  
Municipal well within one mile:  yes  no

If OWWO: old well info as follows:

Operator  
Well Name  
Comp Date Old Total Depth  
Projected Total Depth 850 feet  
Projected Formation at TD Weiser Shale  
Expected Producing Formations Weiser Sand

Depth to Bottom of fresh water 0-275 feet  
Lowest usable water formation Douglas Shale  
Depth to Bottom of usable water 175 feet  
Surface pipe by Alternate: 1  2   
Surface pipe to be set 20 feet  
Conductor pipe if any required -- feet  
Ground surface elevation 776 feet MSL  
This Authorization Expires 2-26-86  
Approved By 8-26-85

I certify that we will comply with K.S.A. 55-101, et seq., plus eventually plugging hole to K.C.C. specifications.


Date 8-23-85 Signature of Operator or Agent Robert T. Hopkins Title Owner

*Rich for KCFE*

Must be filed with the K.C.C. five (5) days prior to commencing well  
 This card void if drilling not started within six (6) months of date received by K.C.C.

**Important procedures to follow:**

**A Regular Section of Land  
 1 Mile = 5,280 Ft.**

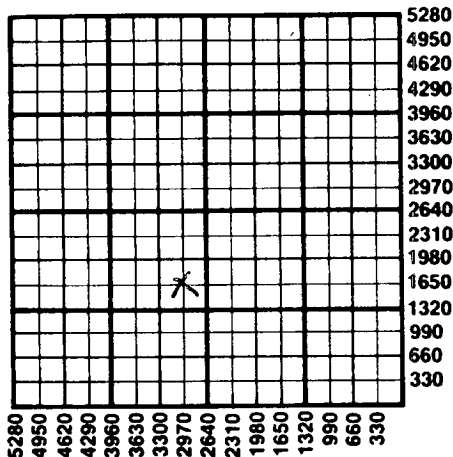

1. Notify District office before setting surface casing.
  2. Set surface casing by circulating cement to the top.
  3. File completion forms ACO-1 with K.C.C. within 90 days of well completion, following instructions on ACO-1, side 1, and including copies of wireline logs.
  4. Notify District office 48 hours prior to old well workover or re-entry.
  5. Prior to plugging, prepare a plugging plan, then obtain agreement from the appropriate district office for an approved plugging plan.
  6. Submit plugging report (CP-4) to K.C.C. after plugging is completed.
  7. Obtain an approved injection docket number before disposing of salt water.
  8. Notify K.C.C. within 10 days when injection commences or terminates.
9. If an alternate 2 completion, cement in the production pipe from below any usable water to surface within 120 days of spud date.

RECEIVED  
 STATE CORPORATION COMMISSION

AUG 26 1985

State Corporation Commission of Kansas  
 Conservation Division  
 200 Colorado Derby Building  
 Wichita, Kansas 67202  
 (316) 263-3238

CONSERVATION DIVISION  
 Wichita, Kansas

8-26-85