

CARD MUST BE TYPED

State of Kansas NOTICE OF INTENTION TO DRILL

(see rules on reverse side)

CARD MUST BE SIGNED

Starting Date: 8 29 1985
month day year

OPERATOR: License # 8972
Name Robert Hopkins
Address P.O. Box 310
City/State/Zip Sedan, KS 67361
Contact Person Robert Hopkins
Phone 316 725-5602

CONTRACTOR: License #
Name Unknown
City/State

Well Drilled For:	Well Class:	Type Equipment:
<input checked="" type="checkbox"/> Oil	<input checked="" type="checkbox"/> Infield	<input checked="" type="checkbox"/> Mud Rotary
<input type="checkbox"/> Gas	<input type="checkbox"/> Pool Ext.	<input type="checkbox"/> Air Rotary
<input type="checkbox"/> OWWO	<input type="checkbox"/> Wildcat	<input type="checkbox"/> Cable
<input type="checkbox"/> Swd		
<input type="checkbox"/> Inj		
<input type="checkbox"/> Expl		

If OWWO: old well info as follows:

Operator
Well Name
Comp Date Old Total Depth
Projected Total Depth 850 feet
Projected Formation at TD Weiser Shale
Expected Producing Formations Weiser Sand

I certify that we will comply with K.S.A. 55-101, et seq., plus eventually plugging hole to K.C.C. specifications.

Date 8-23-85
Signature of Operator or Agent

Robert Hopkins

Title Owner

API Number 15- 125-27,989-00-00

NW SE SW Sec 2 Twp 34 S, Rge 13
(location) ☒ East ☐ West

990 Ft North from Southeast Corner of Section
3630 Ft West from Southeast Corner of Section
(Note: Locate well on Section Plat on reverse side)

Nearest lease or unit boundary line 990 feet.
County Montgomery
Lease Name D. Ball Well# 59

Domestic well within 330 feet: ☐ yes ☒ no
Municipal well within one mile: ☐ yes ☒ no

Depth to Bottom of fresh water 75 feet
Lowest usable water formation Douglas Shale
Depth to Bottom of usable water 175 feet
Surface pipe by Alternate: 1 ☐ 2 ☒
Surface pipe to be set 20 feet
Conductor pipe if any required 76 feet
Ground surface elevation 764 feet MSL
This Authorization Expires 2-26-86
Approved By 8-26-85


RCH for K.C.C.

Must be filed with the K.C.C. five (5) days prior to commencing well
This card void if drilling not started within six (6) months of date received by K.C.C.

9

Important procedures to follow :

A Regular Section of Land 1 Mile = 5,280 Ft.

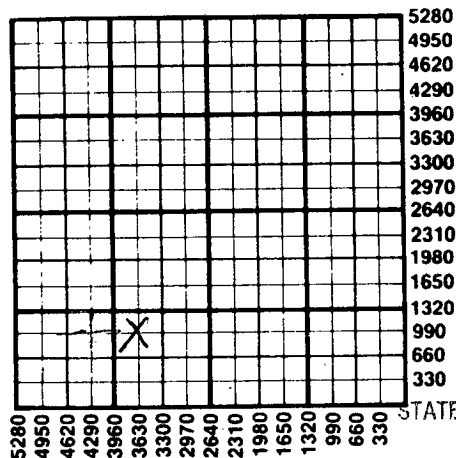

1. Notify District office before setting surface casing.
2. Set surface casing by circulating cement to the top.
3. File completion forms ACO-1 with K.C.C. within 90 days of well completion, following instructions on ACO-1, side 1, and including copies of wireline logs.
4. Notify District office 48 hours prior to old well workover or re-entry.
5. Prior to plugging, prepare a plugging plan, then obtain agreement from the appropriate district office for an approved plugging plan.
6. Submit plugging report (CP-4) to K.C.C. after plugging is completed.
7. Obtain an approved injection docket number before disposing of salt water.
8. Notify K.C.C. within 10 days when injection commences or terminates.
9. If an alternate 2 completion, cement in the production pipe from below any usable water to surface within 120 days of spud date.

RECEIVED

STATE CORPORATION COMMISSION

AUG 26 1985

CONSERVATION DIVISION
Wichita, Kansas

State Corporation Commission of Kansas
Conservation Division
200 Colorado Derby Building
Wichita, Kansas 67202
(316) 263-3238

8-26-85