

CARD MUST BE TYPED

State of Kansas
NOTICE OF INTENTION TO DRILL
(see rules on reverse side)

CARD MUST BE SIGNED

Starting Date: 8 29 1985
month day year

API Number 15- 125-27990-00-00

OPERATOR: License # 8972
Name Robert Hopkins
Address P.O. Box 310
City/State/Zip Sedan, KS 67361
Contact Person Robert Hopkins
Phone 316 725-5602

SW NE SW Sec 2... Twp 34. S, Rge 13. East
(location) West
.....1650..... Ft North from Southeast Corner of Section
.....3630..... Ft West from Southeast Corner of Section
(Note: Locate well on Section Plat on reverse side)

CONTRACTOR: License #
Name Unknown
City/State

Nearest lease or unit boundary line990..... feet.
County Montgomery
Lease Name D. Ball Well# 60

Well Drilled For: **Well Class:** **Type Equipment:**
 Oil Swd Infield Mud Rotary
 Gas Inj Pool Ext. Air Rotary
 OWWO Expl Wildcat Cable

Domestic well within 330 feet : yes no
Municipal well within one mile : yes no

If OWWO: old well info as follows:
Operator
Well Name
Comp Date Old Total Depth
Projected Total Depth 850 feet
Projected Formation at TD Weiser Shale
Expected Producing Formations Weiser Sand

Depth to Bottom of fresh water # 275 feet
Lowest usable water formation Douglas Shale
Depth to Bottom of usable water 175 feet
Surface pipe by Alternate : 1 2 20 feet
Surface pipe to be set feet
Conductor pipe if any required feet
Ground surface elevation 765 feet MSI
This Authorization Expires 2-26-86
Approved By 8-26-85 RCH-BKDAE


I certify that we will comply with K.S.A. 55-101, et seq., plus eventually plugging hole to K.C.C. specifications.

Date 8-23-85 Signature of Operator or Agent Robert T. Hopkins Title Owner

Must be filed with the K.C.C. five (5) days prior to commencing well
 This card void if drilling not started within six (6) months of date received by K.C.C.

Important procedures to follow :

**A Regular Section of Land
 1 Mile = 5,280 Ft.**

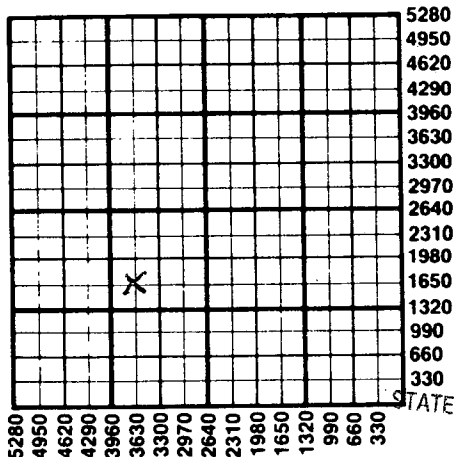

1. Notify District office before setting surface casing.
2. Set surface casing by circulating cement to the top.
3. File completion forms ACO-1 with K.C.C. within 90 days of well completion, following instructions on ACO-1, side 1, and including copies of wireline logs.
4. Notify District office 48 hours prior to old well workover or re-entry.
5. Prior to plugging, prepare a plugging plan, then obtain agreement from the appropriate district office for an approved plugging plan.
6. Submit plugging report (CP-4) to K.C.C. after plugging is completed.
7. Obtain an approved injection docket number before disposing of salt water.
8. Notify K.C.C. within 10 days when injection commences or terminates.
9. If an alternate 2 completion, cement in the production pipe from below usable water to surface within 120 days of spud date.

RECEIVED

STATE CORPORATION COMMISSION

State Corporation Commission of Kansas
 Conservation Division
 200 Colorado Derby Building
 Wichita, Kansas 67202
 (316) 263-3238

AUG 26 1985

CONSERVATION DIVISION
 Wichita, Kansas

8-26-85