

NOTICE OF INTENTION TO DRILL

(see rules on reverse side)

Expected Spud Date... 12/08/87 month day year

OPERATOR: License # 4905

Name K.C. CRUDE

Address 6520 W. 110TH ST., SUITE 106

City/State/Zip OVERLAND PARK 66211

Contact Person STEVE ALLEE

Phone (913) 345-8000

CONTRACTOR: License #

Name UNKNOWN

City/State

Well Drilled For: Well Class: Type Equipment:

- Oil Storage XX Infield XX Mud Rotary
Gas XX Inj Pool Ext Air Rotary
OWWO Expl Wildcat Cable

If OWWO: old well info as follows:

Operator
Well Name
Comp Date Old Total Depth

I certify that well will comply with K.S.A. 55-101, et seq., plus eventually plugging hole to KCC specifications.

Date 12/07/87 Signature of Operator or Agent

Greg Engleman AS AGENT

For KCC Use:

Conductor Pipe Required feet; Minimum Surface Pipe Required 20 feet per Alt.

This Authorization Expires 6-7-88 Approved By PCH 12-7-87

EFFECTIVE DATE: 12-12-87

API Number 15- 125-28,942-00-000

SE NE SE Sec. 2 Twp. 34 S, Rg. 13 XX East

1540 Ft. from South Line of Section

440 Ft. from East Line of Section

(Note: Locate well on Section Plat on reverse side)

Nearest lease or unit boundary line 440 feet

County MONTGOMERY

Lease Name BRADY Well # W-19

Ground surface elevation feet MSL

Domestic well within 330 feet: yes XX no

Municipal well within one mile: yes XX no

Depth to bottom of fresh water

Depth to bottom of usable water 175

Surface pipe by Alternate: 1 2 XX

Surface pipe planned to be set 40

Conductor pipe required

Projected Total Depth 700 feet

Formation REDD. SAND


2

Must be filed with the K.C.C. five (5) days prior to commencing well  
This card void if drilling not started within six (6) months of date received by K.C.C.

### Important procedures to follow:

1. Notify District office before setting surface casing.
2. Set surface casing by circulating cement to the top.
3. File completion forms ACO-1 with K.C.C. within 120 days of well spud date, following instructions on ACO-1, side 1, and including copies of wireline logs.
4. Notify District office 48 hours prior to old well workover or re-entry.
5. Prior to filing Intent, prepare a proposed plugging plan in case well is D & A, then obtain approval of plan when calling district office prior to setting surface pipe.
6. Submit plugging report (CP-4) to K.C.C. after plugging is completed.
7. Obtain an approved injection dock number before disposing of salt water.
8. Notify K.C.C. within 10 days of completion commences or terminates.
9. If an alternate 2 completion, cement in the production pipe from below any usable water to surface within 120 days of spud date.

### A Regular Section of Land 1 Mile = 5,280 Ft.

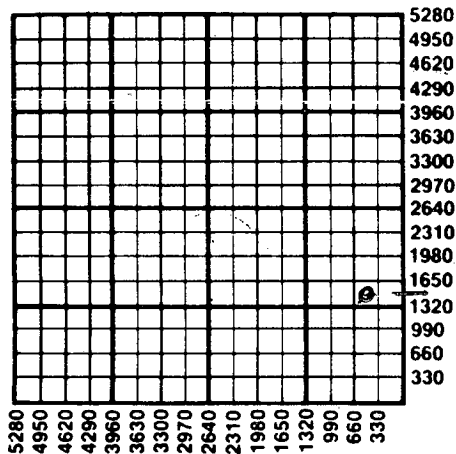

12-7-87

RECEIVED  
STATE CORPORATION COMMISSION  
DEC 7 1987  
CONSERVATION DIVISION  
Wichita, Kansas

State Corporation Commission of Kansas  
Conservation Division  
200 Colorado Derby Building  
Wichita, Kansas 67202-1212  
(316) 263-3238